


PlatBook GGG Page 92



*W. MORGAN ST.
(FORMERLY O'NEAL AVE.)*

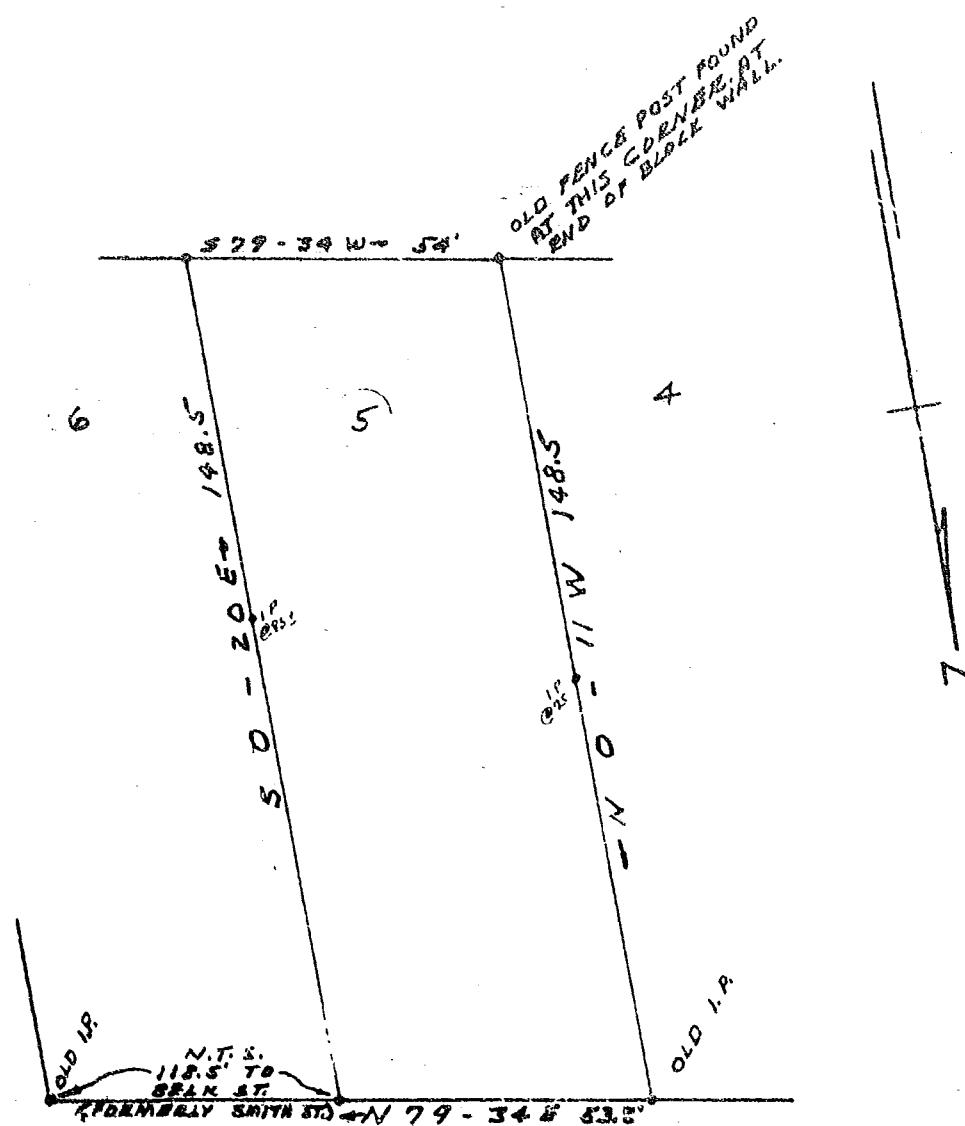

PROPERTY OF
CHARLES W. ELLIS
CLAUDIA M. ELLIS
CITY VIEW S.C.
APRIL 2, 1964 1" = 30'

SURVEYED BY H C Clarkson Jr
SC REG NO 2697
J. E. K. CAMPBELL

$$GGG = 92$$

106

Recorded April 24, 1964 at 8:48 A.M. #30208