

Beck

130

# PROPERTY OF DONALD J. WILLIAMS


ONEAL TOWNSHIP GREENVILLE COUNTY  
SOUTH CAROLINA


SCALE: 1" = 100 FEET

MARCH 14 1963

Survey made March 14 1963

John A. Simmons, Reg. Surveyor #2212  
GREEN, S.C.

FILED  
GREENVILLE CO. S.C.  
JUL 30 4 29 PM 1964  
F. M. C.

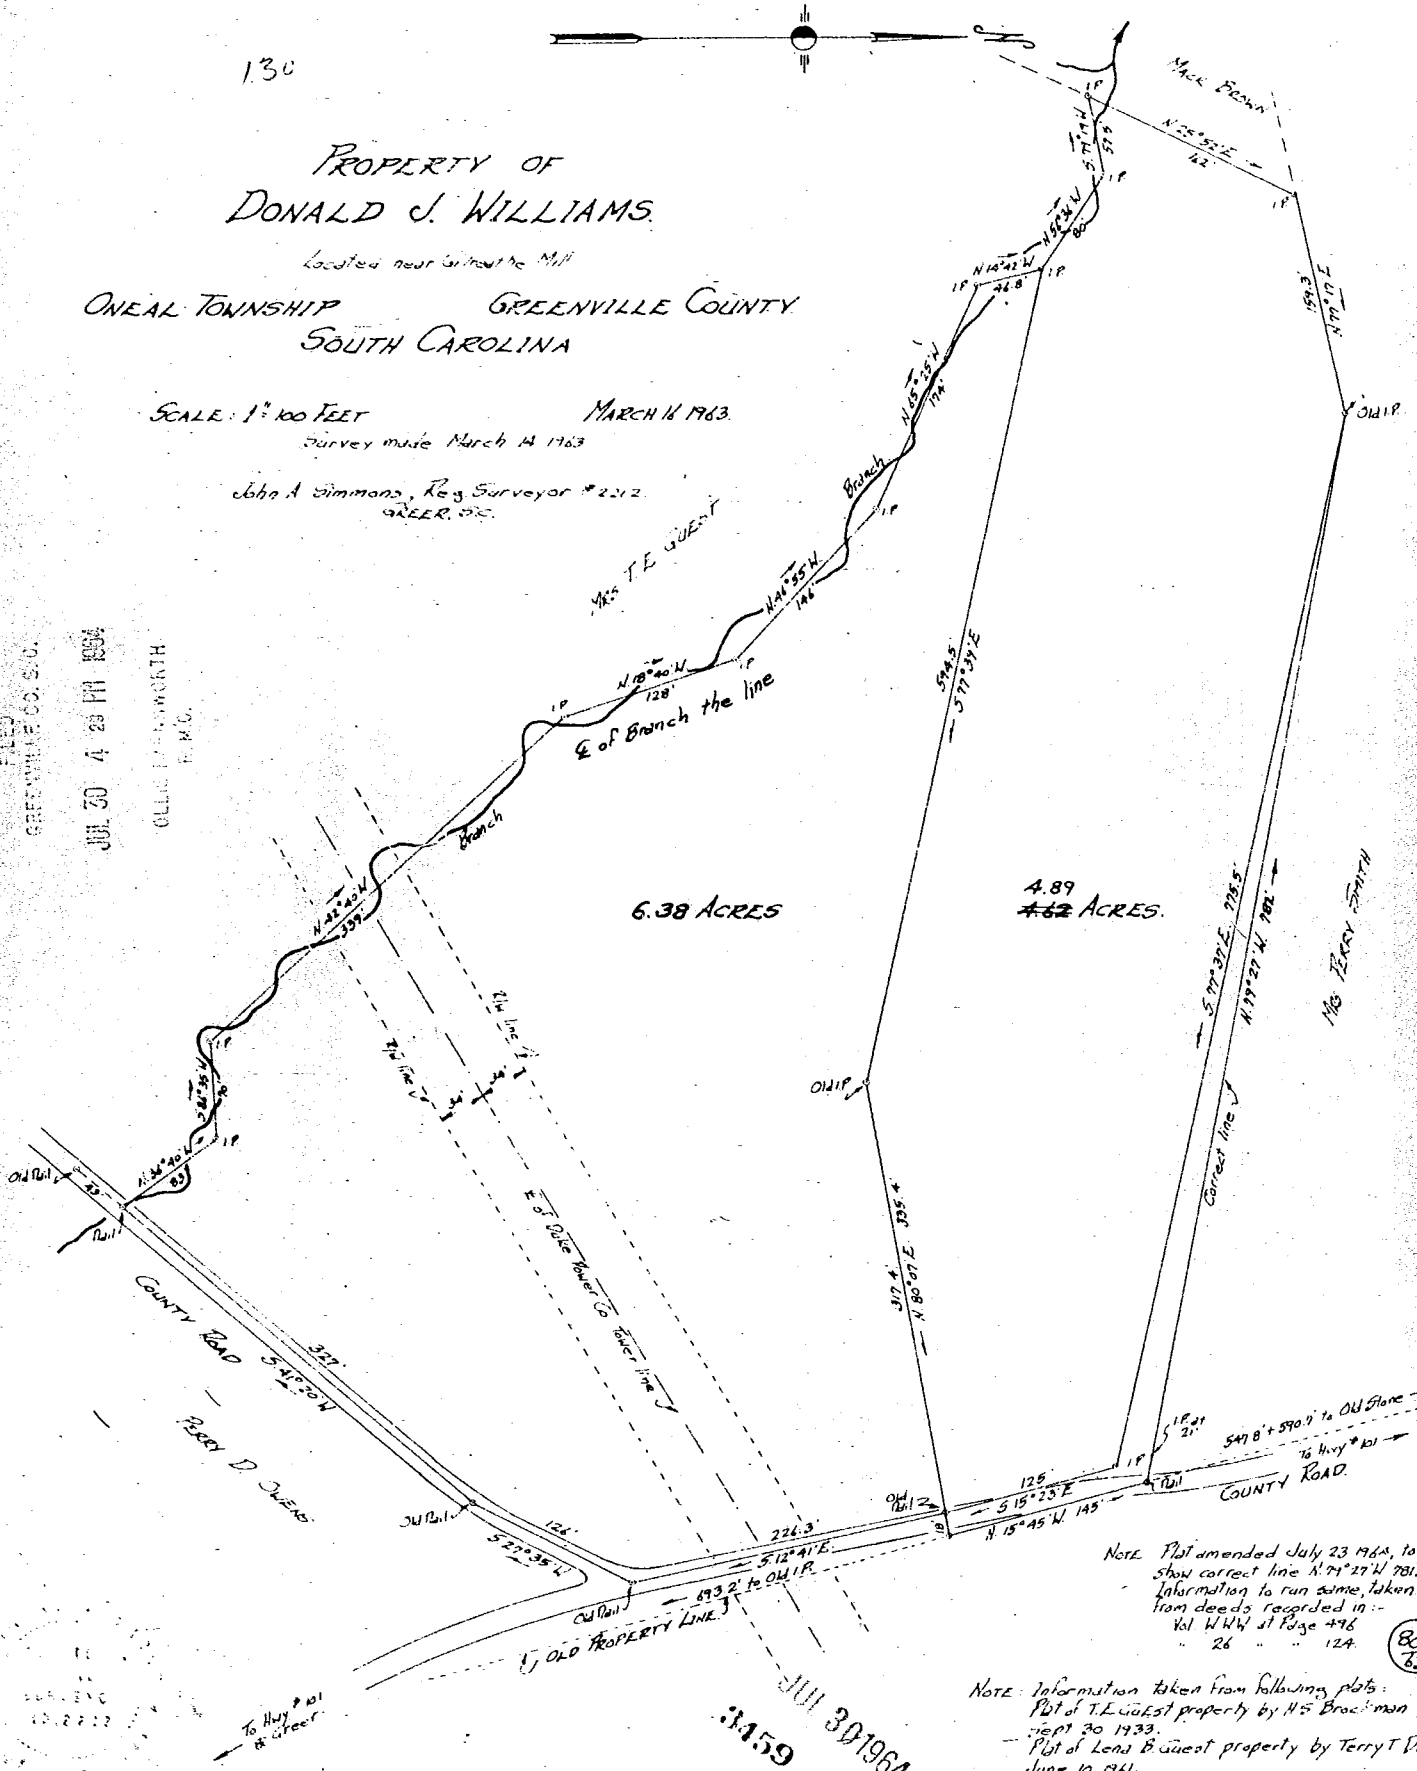

6.38 ACRES

4.89  
~~6.2~~ ACRES.

Note: Plat amended July 23 1964, to show correct line N 74° 27' W 781'. Information to run same, taken from deeds recorded in: Vol. W.W. at Page 496 26 " 124.

Note: Information taken from following plats:  
 - Plat of T.E. Guest property by H.S. Brownman Sept 30 1933.  
 - Plat of Lena B. Guest property by Terry T. Dill June 10 1961.

Recorded July 30, 1964 at 4:29 P. M. #3459


JUL 30 1964  
3459

82  
83