


(2)

GROVER A. AND LYDIA HAWKINS.

RE: SOAK TEST
 26" HOLES IN CLAY
 (HOLE NO. 1) SOAKED 4" WATER PER HR.
 " " 2 " 2 " " "
 " " 3 " 2 " " "
 " " 4 " 5 " " "
 J. Q. BRUCE:
 REG. SUR. S.C. NO. 667
 2-25-1965

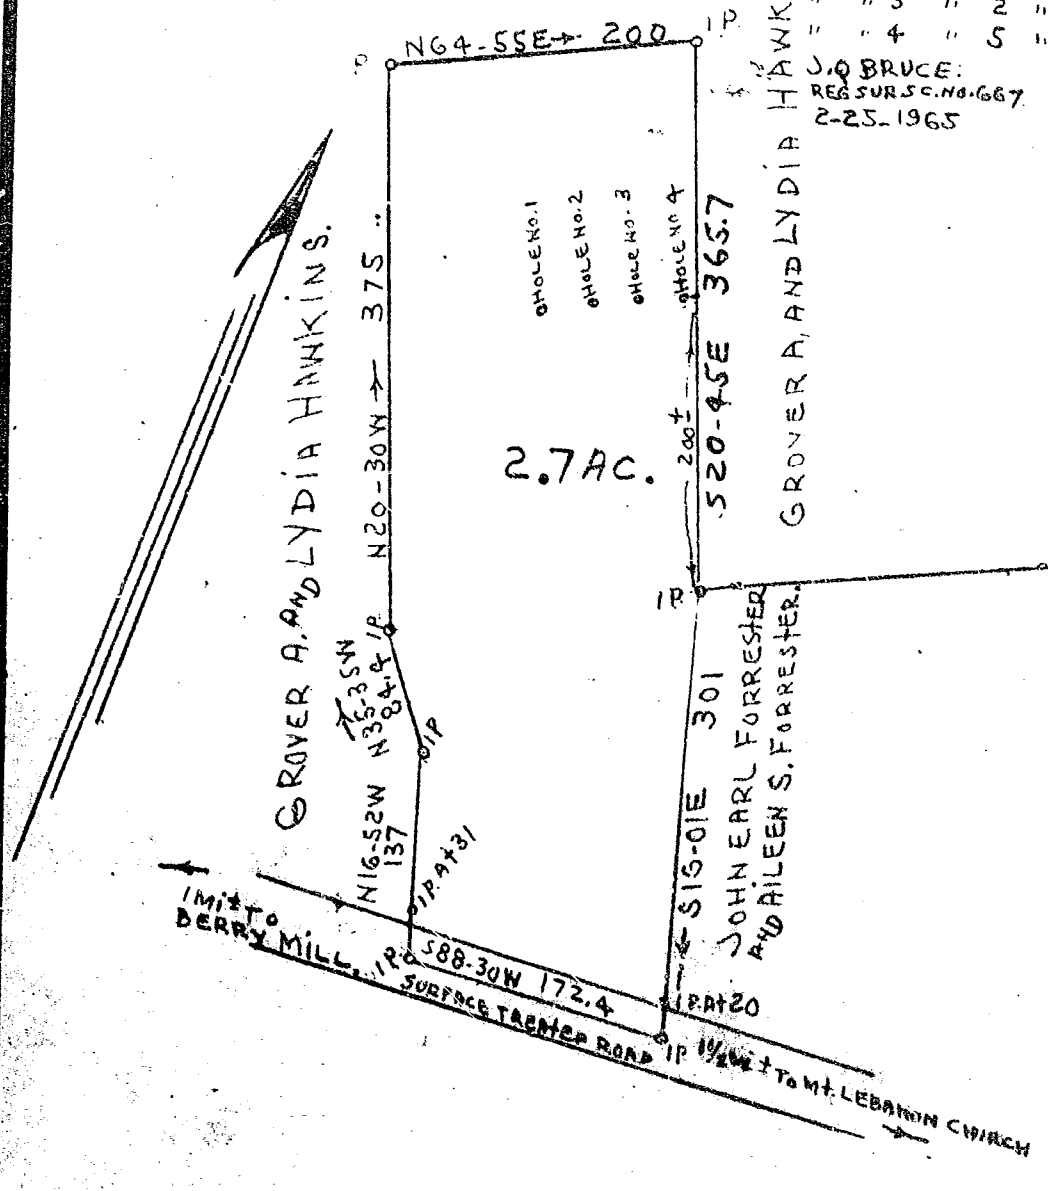

LAND SURVEY FOR
 GROVER A. AND LYDIA HAWKINS.
 GREENVILLE CO. S.C. 1"=100' 6-2-1964.
 PART VOL. 203, PG. 213, HIGHLAND TWP.
 J. Q. BRUCE: REG. SUR. S.C. NO. 667.

FILED
 GREENVILLE CO. S.C.
 MAR 9 3 54 PM 1965
 OLIE F. SMITH
 R.M.C.

MAR 9 1965
 25105

See 8/02

Recorded March 9, 1965 at 3:54 P.M. 25105

P. C. ...