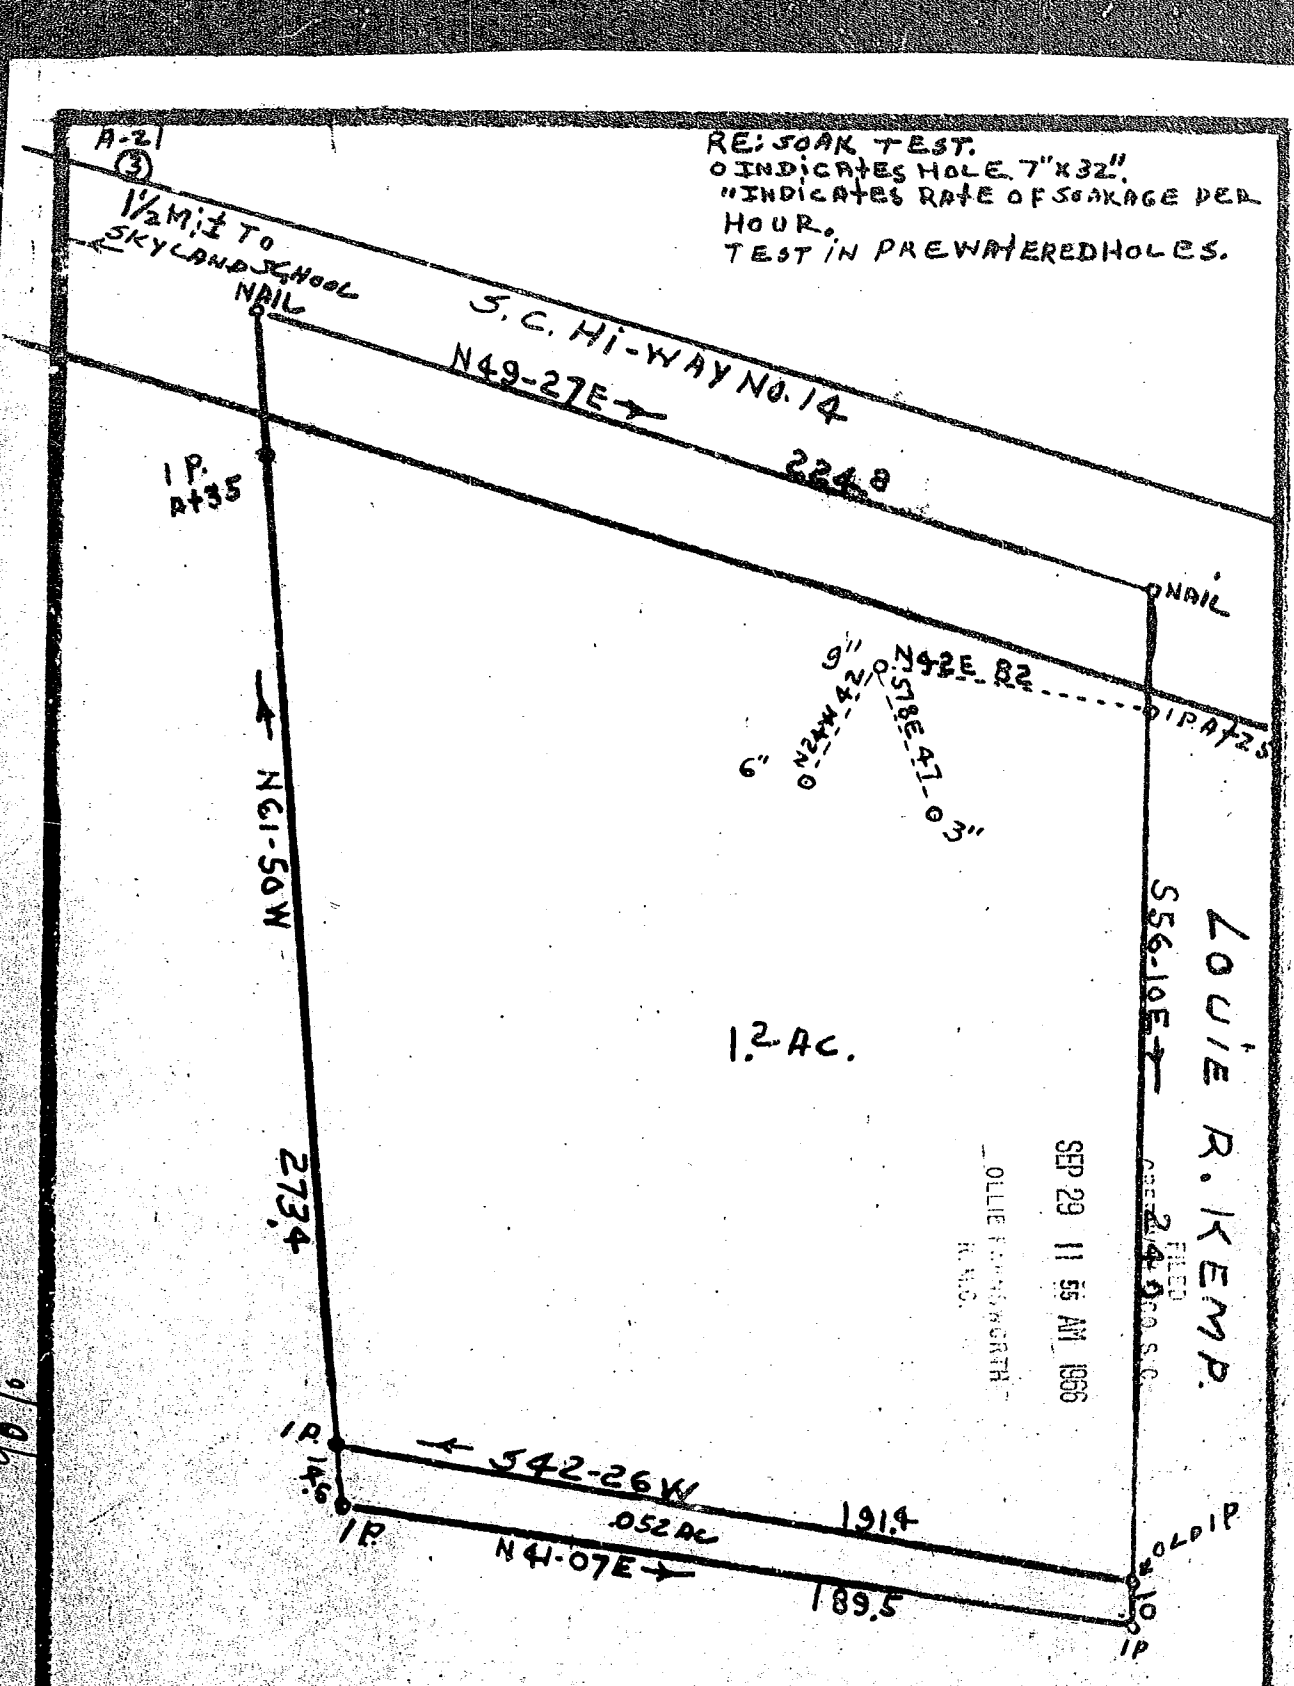

RE: SOAK TEST.
O INDICATES HOLE 7"X32".
"INDICATES RATE OF SOAKAGE PER HOUR.
TEST IN PREWATERED HOLES.

LAND SURVEY FOR
A. B. KEMP: G'VILLE CO. S. C.
IS PART VOL. 541-328. 3-16-1966 1"= 50'
J. Q BRUCE: REG. SURVEYOR S. C. NO. 667


8640 Recorded September 29, 1966 at 11:55 A. M.