


REF: A PORTION OF THE H.V. BARKER PROPERTY RECORDED IN THE R.M.C. OFFICE OF GREENVILLE COUNTY IN DEEDBOOK 573 @ 221.

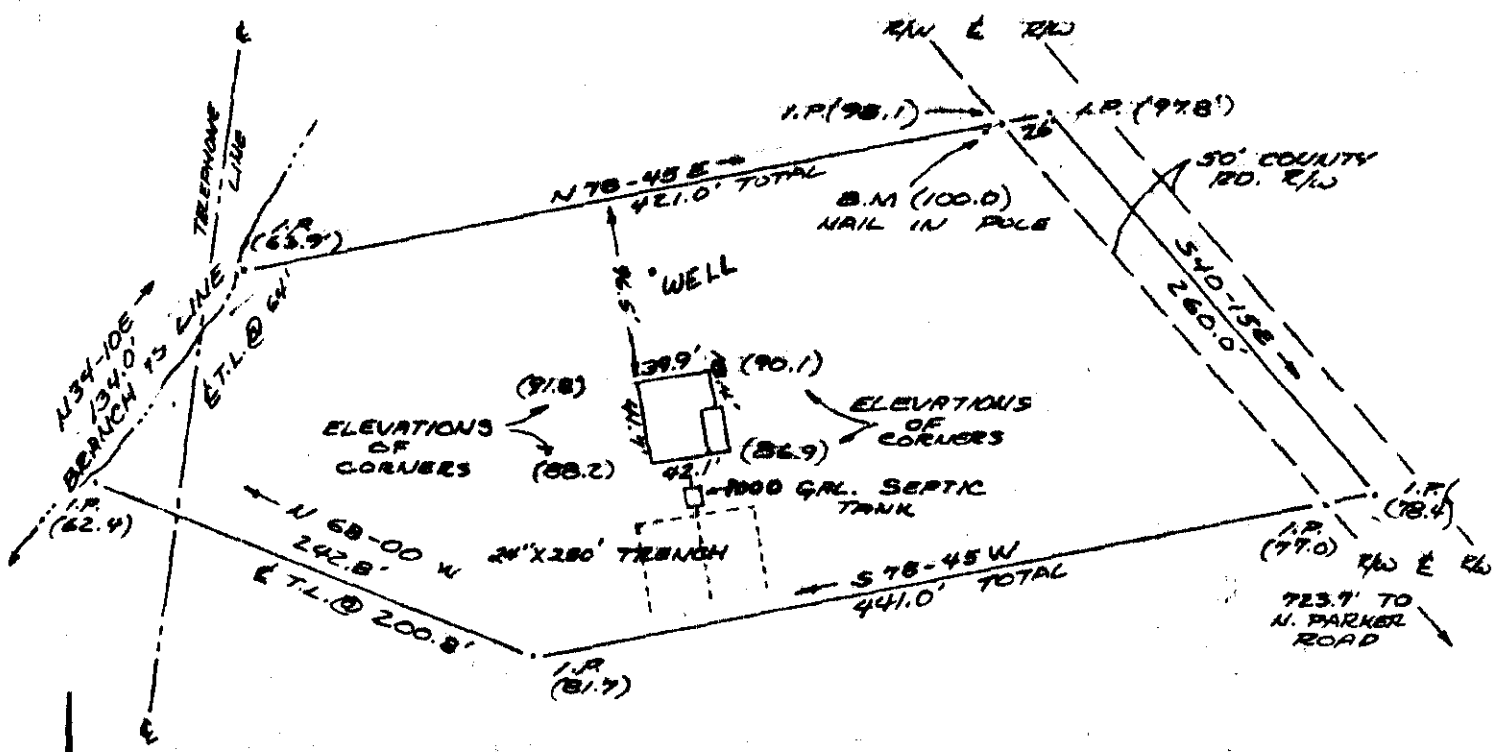

NOTE: PARENTHESES () INDICATE ELEVATIONS

PROPERTY OF
JOHN O. LENNING
 NEAR GREENVILLE, S.C.
 SCALE 1"=100' 23 JUNE 1964

This is to certify that on the 23rd day of June 1964, I surveyed the property shown on this plat, and that the property lines are as shown hereon and that no adjacent buildings or walls encroach or project on said premises.

FILED
 GREENVILLE CO.
 OCT 8 9 57 AM 1964
 OLLIE FAIRSWORTH
 R.M.C.

R. B. Bruce
 R.B. Bruce, R.L.S. #1952

OCT 8 - 1964
 10619

10619-103 CAROLINA ENGINEERING & SURVEYING CO.
 GREENVILLE, S.C.

10619 Filed This 8 day of Oct 19 64
 And Recorded in Vol. 1017 Page 103 as
OLLIE FAIRSWORTH
 Register Mesne Conveyance Greenville County, S. C.