


NOV 24 11 14 AM 1964

OLLIE FARNSWORTH
R. M.C.

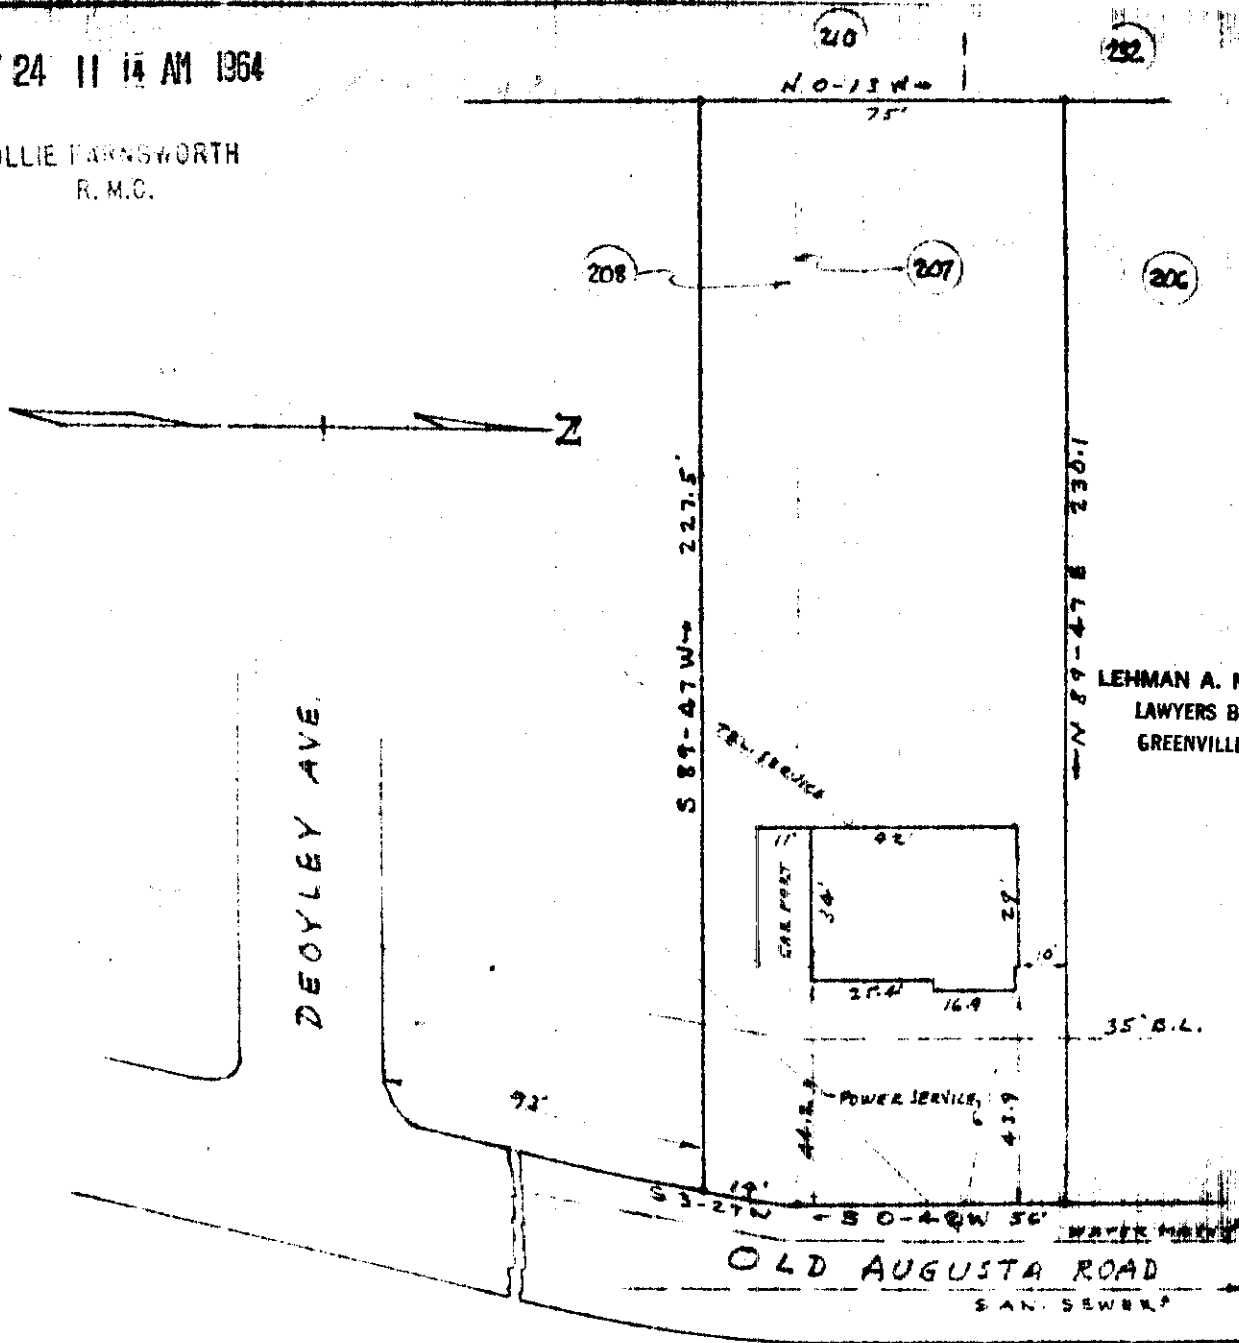

LEHMAN A. MOSELEY, JR., ATTORNEY
LAWYERS BLDG. - P. O. Box 10,345
GREENVILLE, S. C. - PH. 232-5419

This is to certify that on Nov. 23, 1964, I surveyed the property shown on this plat, known as Lot No. 207 & a portion of Lot No. 208 adjacent thereto, on plat of Augusta Road Ranches, filed in the R.M.C. Office for Greenville Co. in Plat Book M at page 47, and that the property lines, walls and building are as shown hereon; that the building located on said lot does not encroach or project on adjacent streets or property and that no adjacent walls or buildings encroach or project on said premises, and that no utility lines cross this property except as shown hereon.

Surveyed by RK Campbell

NOV 24 1964

R.M.C. Reg. No. 996

PROPERTY OF 15205

504

JAMES R. MIMS JR. & SARA K. MIMS

GREENVILLE S. C.

P.B.

SCALE 1" = 40' NOV. 23, 1964

H.H.H. - 125

15205 Filed This 24 day of Nov. 1964

And Recorded in Vol. H.H.H. Page 125 at 11:14 AM.

Ollie Farnsworth

Register Mesne Conveyance Greenville County, S. C.