


EAST WASHINGTON ST

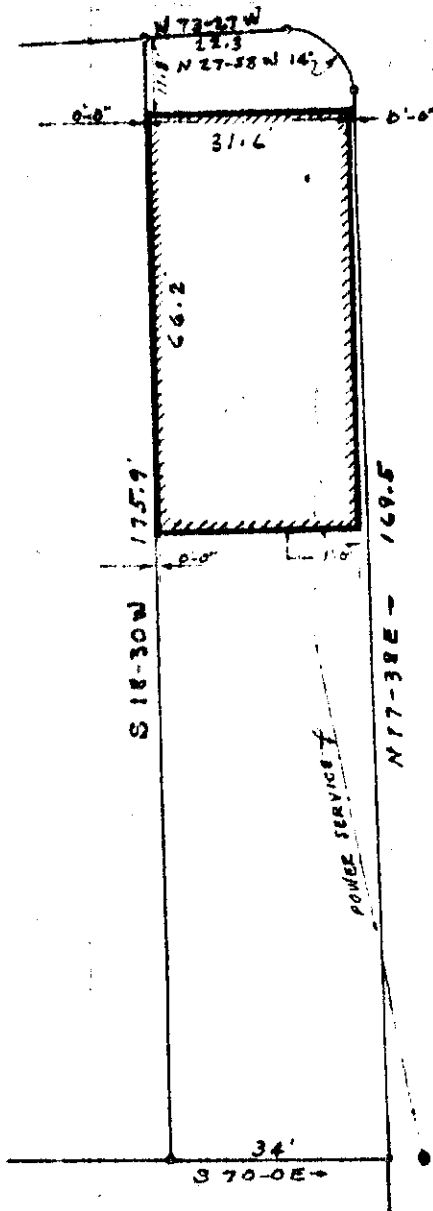

MORDECAI STREET

This is to certify that on Nov. 10, 1964, I surveyed the property shown on this plat, known as a portion of Lot 1, Block 2 of City Block Book page 92 in Greenville Co. Court House, and that the property lines, walls and building are as shown hereon; that the building located on said lot does not encroach or project on adjacent streets or property, and that no adjacent walls or buildings encroach or project on said premises, and that no utility lines cross this property except as shown hereon.

Surveyed by H.C. Clark

S.C. Reg. No. 2589

Plat of this property filed in the R. & C. Office for Greenville Co. in Plat Book 636 at page 130.

PROPERTY OF
 COMPRESSOR CORP. OF AMERICA
 GREENVILLE S.C.
 SCALE 1" = 30' NOV. 10, 1964

OLLIE FARRS WORTH
 R.M.O.

DEC 1 3 35 PM 1964

FILED
 GREENVILLE CO. S.C.

DEC 1 1964

15741

- 133

15741 Filed This 1 day of Dec. 19 64
 And Recorded in Vol. ## Page 133 at 3:35 P.M.
Ollie F. Worth
 Register Mesne Conveyance Greenville County, S. C.