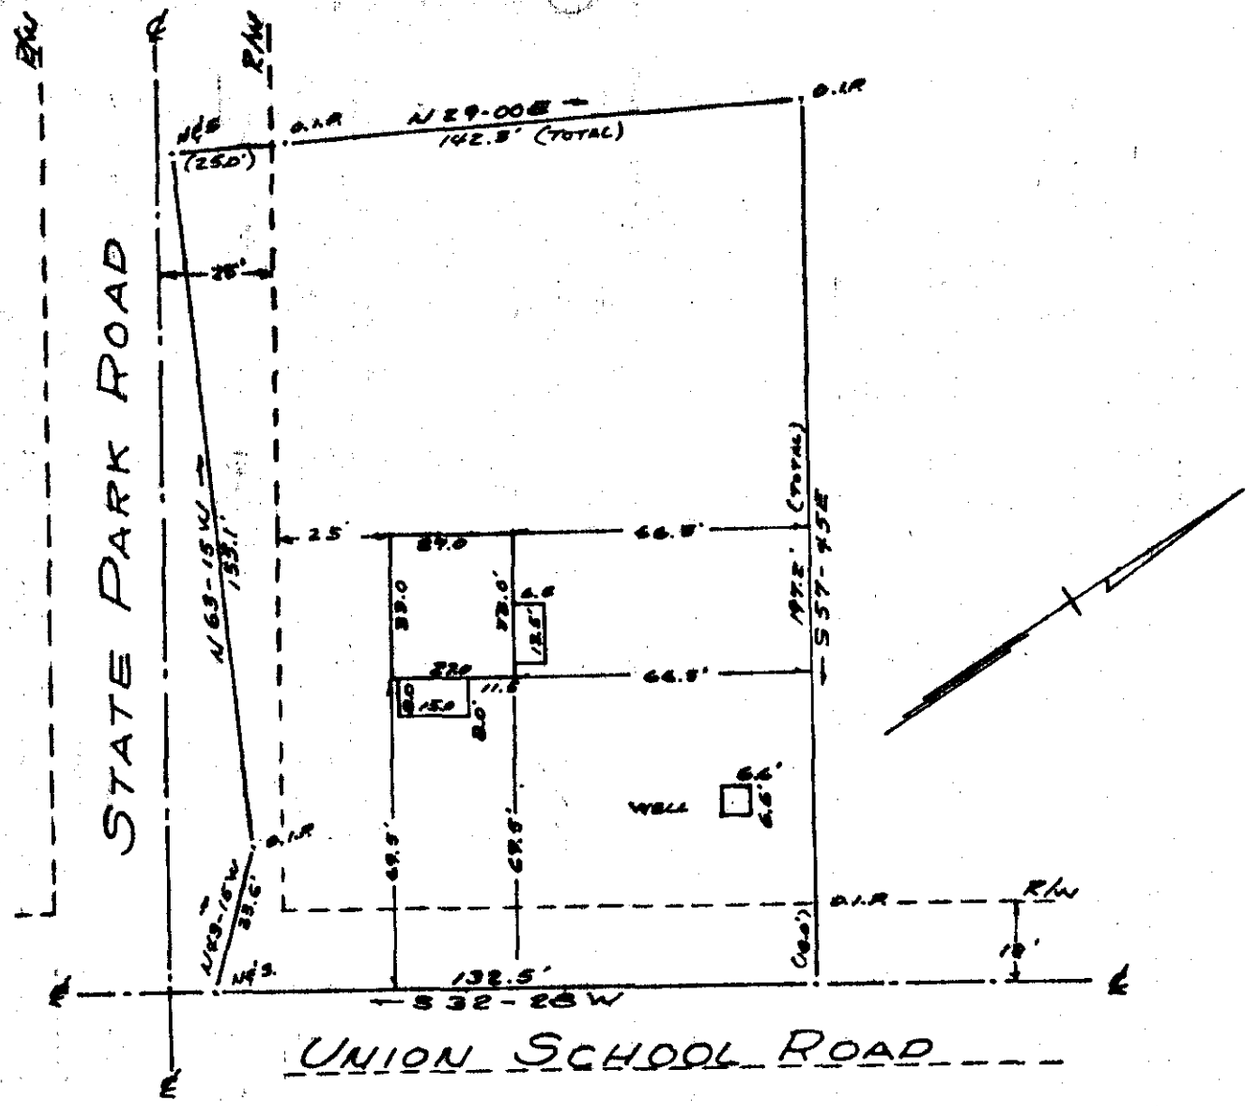

PROPERTY OF

KENNETH E. EVANS & EDDIE R. EVANS

NEAR GREENVILLE, S.C.

SCALE 1" = 40' & JULY 1965

This is to certify that on the 6th day of July 1965, I surveyed the property shown on this plat, being known as property of KENNETH E. EVANS & EDDIE R. EVANS recorded in platbook page , in the R.M.C. Office of Greenville County, S.C.; and that the property lines, walls, and buildings are as shown hereon; and that the buildings located on said lot do not encroach or project onto adjacent street or property, and that no adjacent walls or buildings encroach or project onto said property.

R.B. Bruce

R.B.Bruce, R.L.S. #1952

JUL 28 1965

JUL 28 1965

3225

FILED GREENVILLE CO. S.C. JUL 28 11 41 AM 1965 OLLIE FARNSWORTH R.M.C.

KKK-61 CAROLINA ENGINEERING & SURVEYING CO. GREENVILLE, S.C.

3225 Filed This 28 day of July 19 65

And Recorded in Vol. KKK Page 61 at 11:41 AM

Ollie Farnsworth

Register Mesne Conveyance Greenville County, S. C.