


LEHMAN A. MOSELEY, JR., ATTORNEY
 LAWYERS BLDG. - P. O. Box 10,345
 GREENVILLE, S. C. - PH. 232-5419

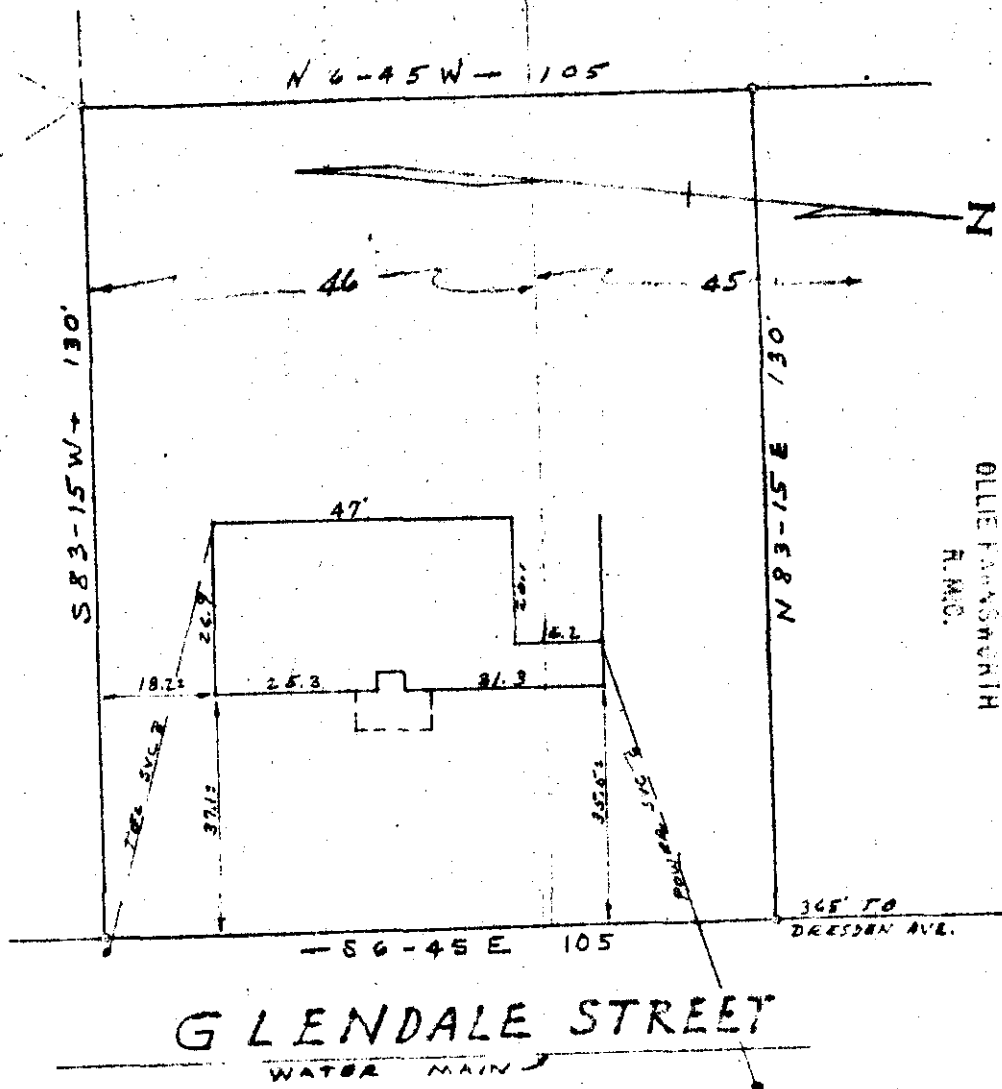

OLLIE HANSMONTH
 F.L.M.C.

AUG 25 12 00 PM 1965

KKK-102

This is to certify that on Aug. 20, 1965, I surveyed the property shown on this plat, known as Lot No. 46 and the southern half of Lot No. 45, on plat of Grendale Heights, filed in the H.M.C. Office for Greenville Co. in Plat Book KK at page 143, and that the property lines, walls and building are as shown hereon; that the building located on said lot does not encroach or project on adjacent streets or property, and that no adjacent walls or buildings encroach or project on said premises, and that no utility lines cross this property except as shown hereon.

Surveyed by KK Campbell

S.C. Reg. No. 996

6235

PROPERTY OF
 H. EUGENE REID
 AND
 ANDREA JEAN REID
 NEAR GREENVILLE S.C.
 SCALE 1" = 30' AUG. 20, 1965

Paste in 504

6235 Filed This 25 day of Aug. 1965
 And Recorded in V. KKK Page 103 at 1:00 PM
Oliver Hansmonth
 Register Mesne Conveyance Greenville County, S. C.