


Plat Book MMM. Page 54

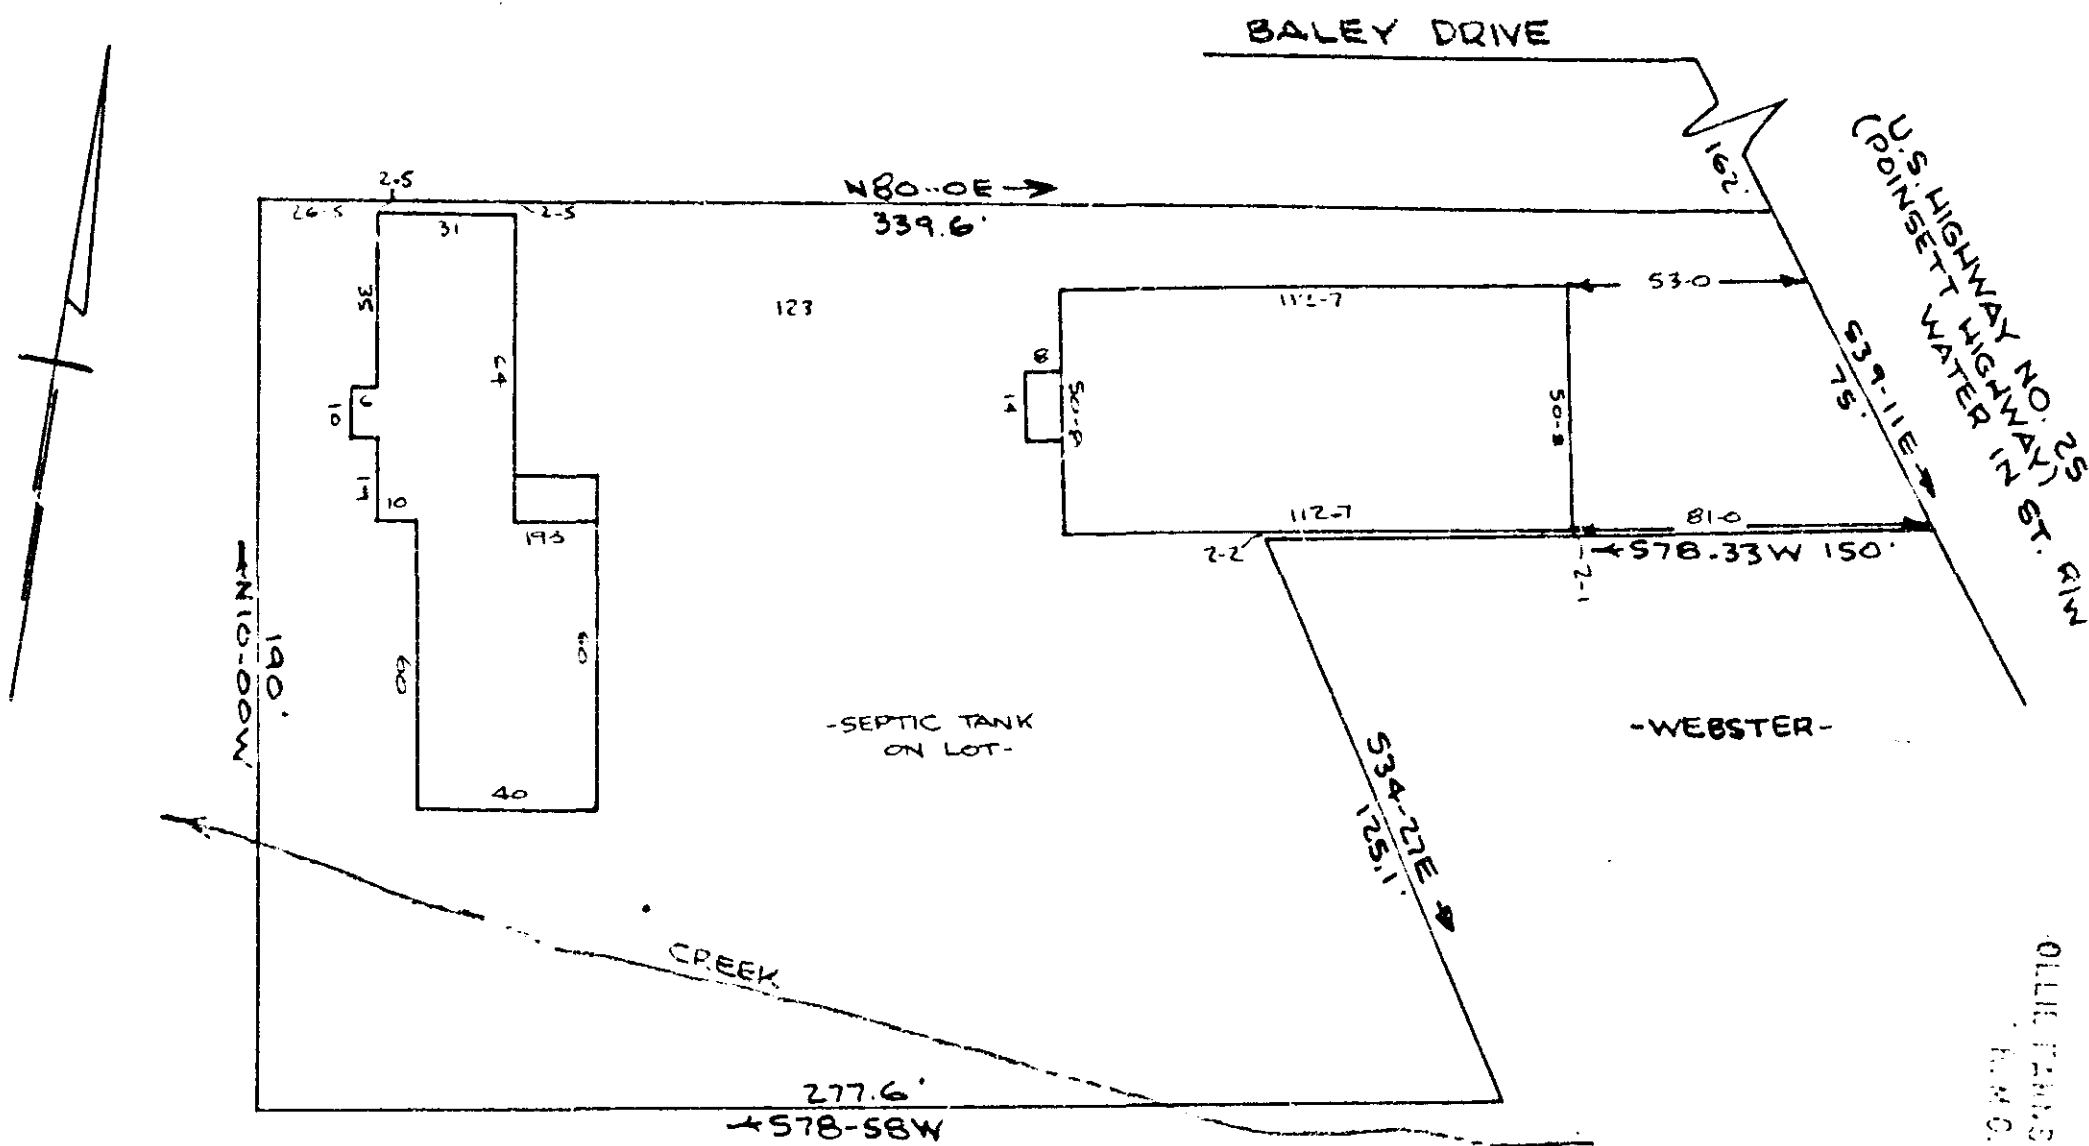

PROPERTY OF
JANITORS CLEANING SERVICE INC.
 NEAR GREENVILLE, S. C.
 SCALE 1"=50' 28 MAY 1966

GREENVILLE CO. S.C.
 JUN 9 10 21 AM 1966
 OLLIE JAMES WORTH
 R.M.C.

This is to certify that on the 23th day of May, 1966 I surveyed the property shown on this plat, being known as property of JANITORS CLEANING SERVICE INC., and recorded in the R.M.C. Office Greenville County, S.C. in plat book page ; and that the property lines, walls and buildings are as shown hereon, and that the buildings locate on said lot do not encroach or project on adjacent street or property, and that no adjacent buildings or walls encroach or project on said premises.

R. B. Bruce
 R.B. Bruce R.L.S. # 1452

.50

MMM - 54 31982

34982 Filed This 9 day of June 19 66
 And Recorded in Vol. MMM Page 54 at 10:11 AM
Ollie James Worth
 Register Mesne Conveyance Greenville County, S. C.