
## Plat Book MMM. Page 117A

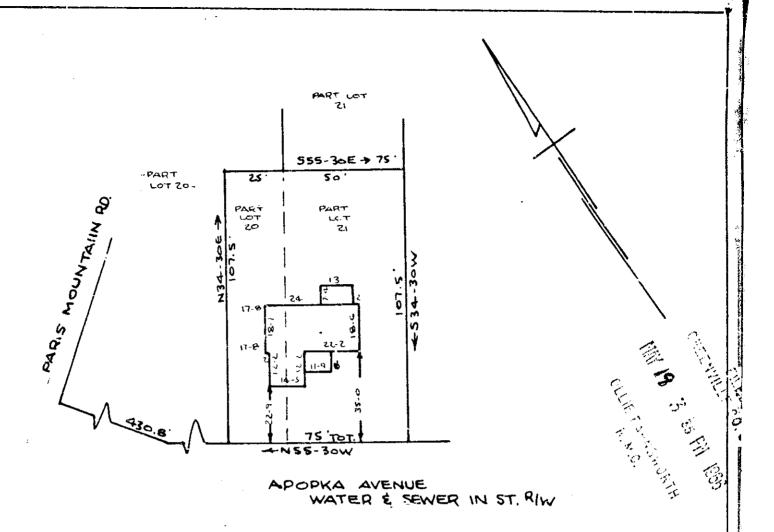

UAMES W. MEADE & MARY G. MEADE
NEAR GREENVILLE, S. C.

This is to certify that on the 14th day of May, 1966 I surveyed the property shown on this plat, being known as a portion on lot 20 and lot 21, on plat of Paris-Piney Fark, and recorded in the m.M.C. Office Greenville County, S.C. in plat book "H" page 19, and also being known as property of James W. Neade and Mary G. Heade and recorded in plat book page; and that the property lines, walls and buildings are as shown hereon, and that the buildin's located on said lot do not encroach or project on adjacent street or property, and that no adjacent buildings or walls encroach or project on said premises.

R. G. Bruce.

CARCLINA ENGINEERING AND JURVLYING CO. GRAENVILLE, S.C.

50

WWW - 1177

32969

33969 Filed This 19 da, of Way 19 66 And Recorded in Voll W M rage 117 at 335 DW.

Register Mesne Conveyance Greenville County, S. C.