
Plat Book MMM. Page 153A

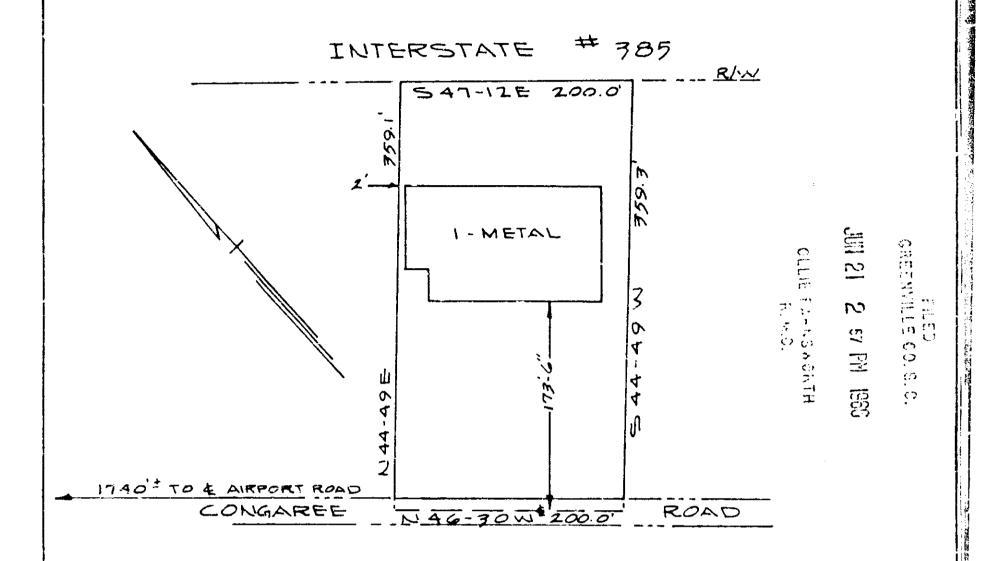

PROPERTY OF

LANG LIGON & CO., INC.

NEAR GREENVILLE, S.C.

SCALE 1"-100" JUNE 7, 1966

This is to certify that on the 7th day of June 1966, I surveyed the property shown on this plat, and that the property lines, walls and buildings are as shown hereon; that the buildings located on said lot do not encreach or project on adjacent streets or property, and that no adjacent walls or buildings encreach or project on this lot, and that there are no utility lines crossing this property except as shown.

Registered Engineer No. 962

PIEDMONT ENGINEERS AND ARCHITECTS

GREENVILLE, S. C.

And Recorded in Vol. M. M. Page 1=3 at 3:57 D. W.

Register Mesne Conveyance Greenville County, S. C.