
## Plat Book MMM. Page 177A

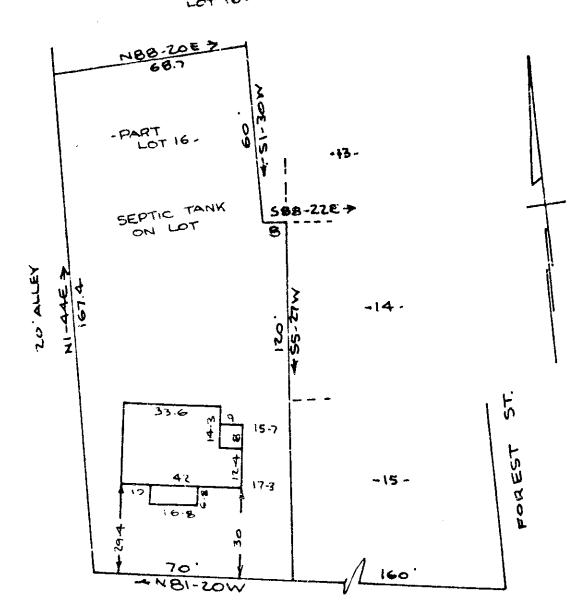

MOUNTAIN VIEW AVENUE WATER IN ST. RIW

PROPERTY

OF D

HENRY V. ROBINSON & MARTHA L. ROBINSON NEAR SREENVILLE ZENLYIGES.

This is to certify that on the 28th day of July, 1966 I surveyed the property shown on this plat, being known as lot 16 on plat of property of W. DENNIS SMITH AND H.J. WATERS, and recorded in the R.M.C. Office Greenville County, S.C. in plat book "Y" page 69, and also being known as property of HENRY V. ROBINSON and MARTHA L. ROBINSON, and recorded in the R.M.C. Office in plat book "MMM" page 177; and that the property lines, walls and buildings are as shown hereon, and that the buildings located on said lot do not encroach or project on adjacent street or property, and that no adjacent street or walls encroach or project on said premises.

12, 6. Bruce R.L.S # 1952

JUL 29 1966

CAROLINA ENGINEERING AND SURVEYING CO. GREENVILLE, S.C.

MMM -177

3126

And Recorded in Vol.M.M. Page 177 at 437 W.M.

Register Mesne Conveyance Greenville County, S. C.