
## Hatbook MIMIN. Page 180

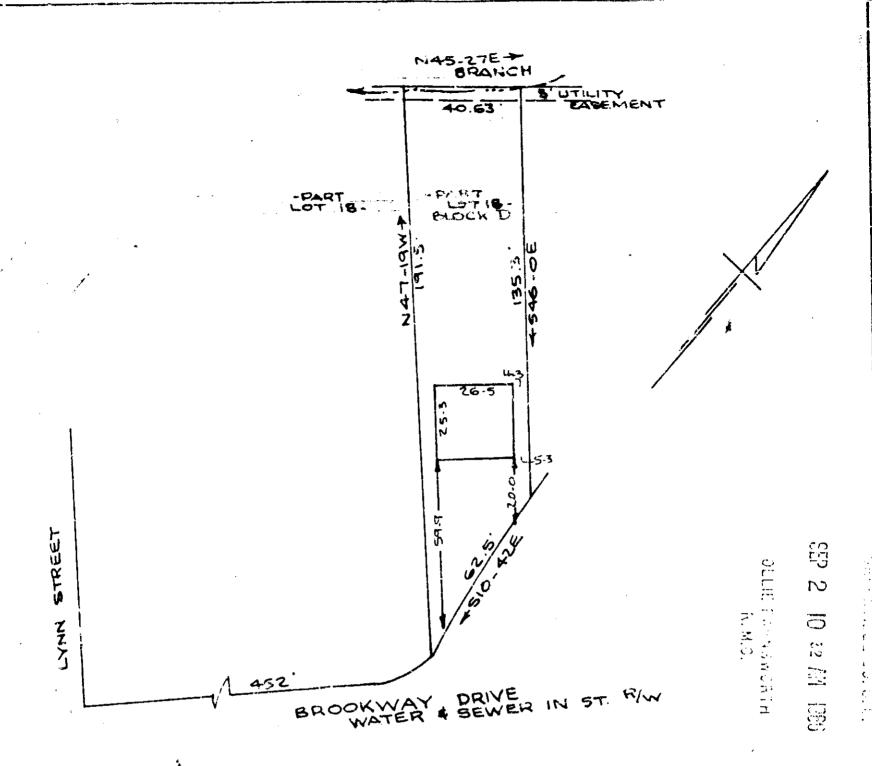

PROPERTY OF

GEORGE E. TATE

GREENVILLE, S.C.
SCALE 1= 40 25 AUG 1966

This is to certify that on the 25th day of August, 1966 I surveyed the property shown on this plat, being known as a portion of bot 1%, block D, on plat of GROVE PARK, and recorded in the R.M.C. Office Greenville County, S.C. in plat book "A" rages 68 1 69; and also being known as property of GEORGE E. TATE, and recorded in the R.M.C. Office in plat book page; and that the property lines, walls and buildings are as shown hereon, and that the buildings located on said lot do not encroach or project on adjacent street or property, and that no adjacent buildings or walls encroach or project on said premises.

B. B. Bruce K.L.S. # 1952

GREENVILLE, S.C. 6391


Register Mesne Consumue Oreenville County, S. C.