
## PLat Book-NNN-Page 40

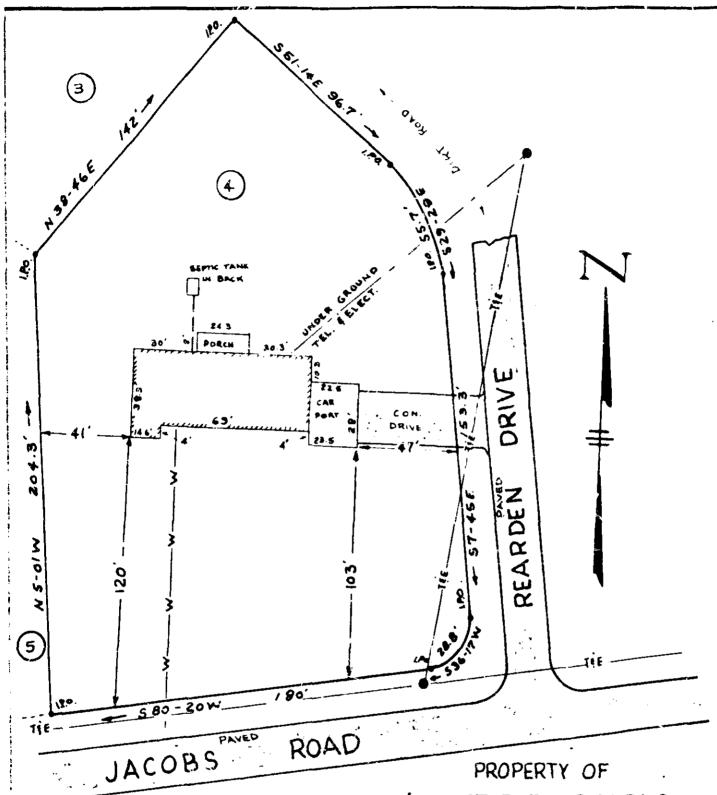

F.C. & MYRTLE E. PICKENS
HEAR GREENVILLE, SOUTH CAROLINA
SCALE (" = 40" SCOT 15 1500

This is to certify that on the 15th day of Sept. 1966, I surveyed the above property, know as Lot No. 4, Plat of property of Fred & Mamie Garrett, Harrison. Rearden, W. F. Gibson and Myrtle F. Piskens; Plat resorded in Plat Book GGG, Page 105, and that the property lines, walls and buildings are as shown hereon; that the buildings located on said property so not encroach or project on adjacent property or Streets; and that no adjacent buildings, walls or power lines encroach or project on said properby except as shown hereon.

September 25, 1966

1.00 8215 MMM-40 C.O. Ridde Rg. 6.5.1347

And Record in Vall II use to at M

Register Masne Conveyance Greenville County, S. C.