PLAT BOOK NNN PAGE 59

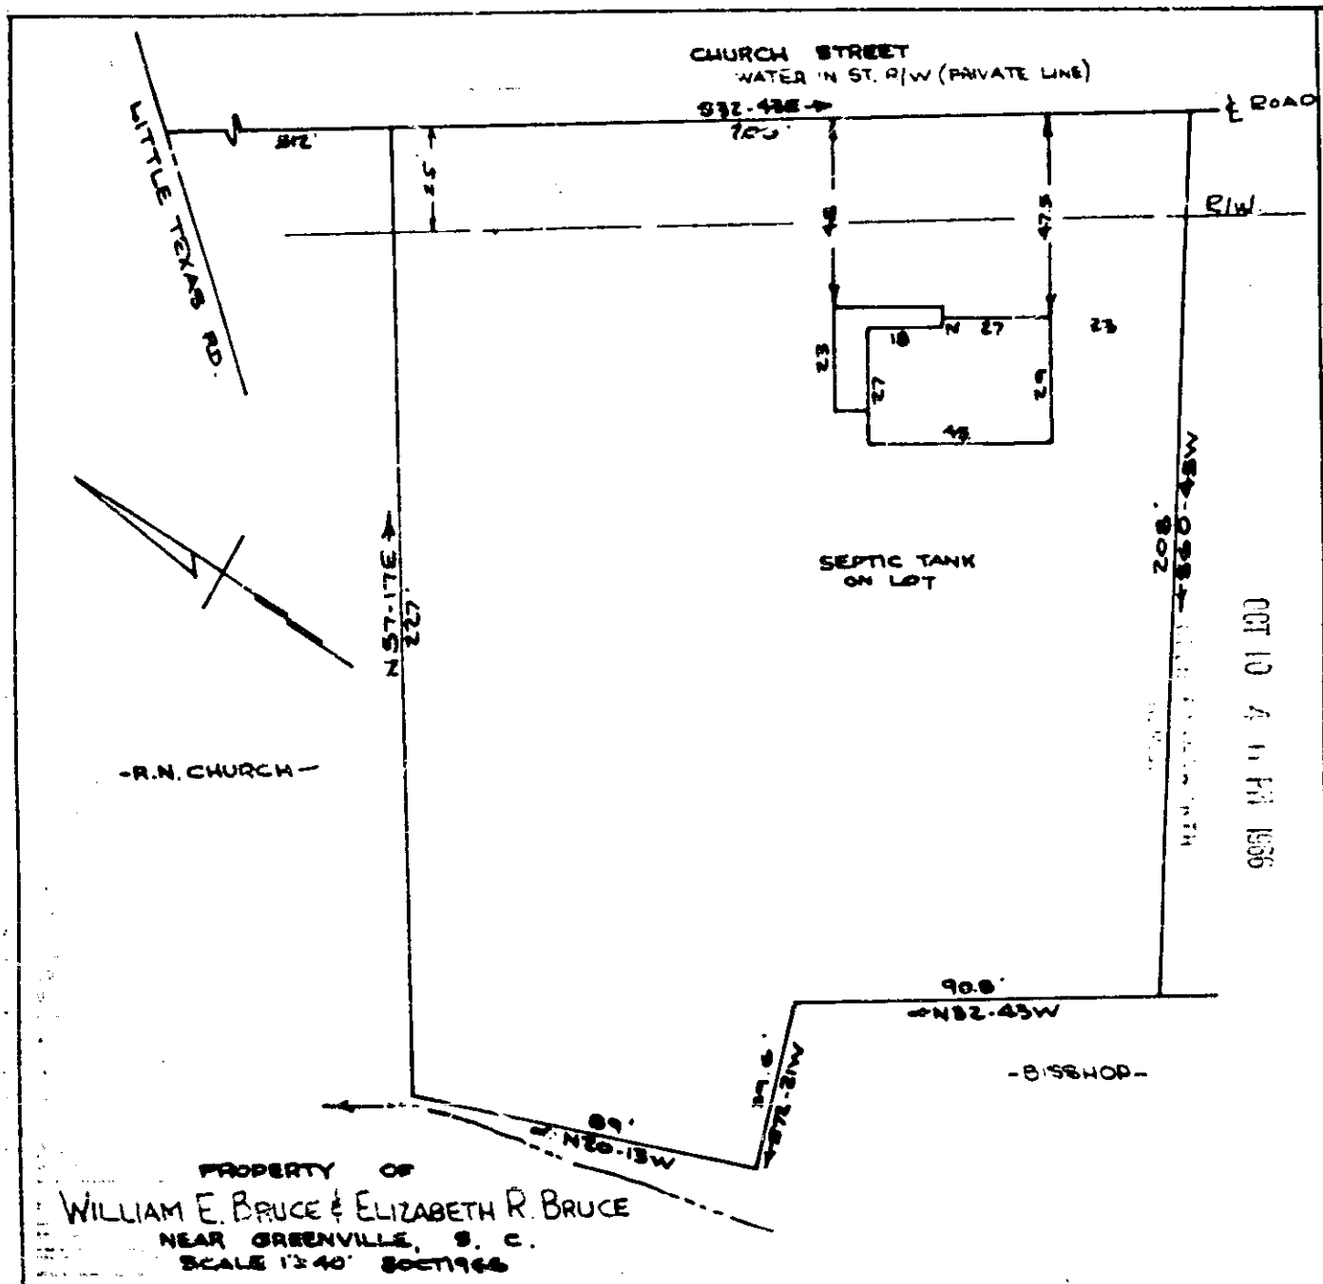

This is to certify that on the 8th day of October, 1966, I surveyed the property shown on this plat, being known as property of WILLIAM E. BRUCE and ELIZABETH R. BRUCE, and recorded in the R.M.C. Office Greenville County, S.C. in plat book page ; and that the property lines, walls and buildings are as shown hereon, and that the buildings located on said lot do not encroach or project on adjacent street or property, and that no adjacent street or walls encroach or project on said premises.

R. B. Bruce
R.E. Bruce R.L.S. # 1952

CAROLINA ENGINEERING AND SURVEYING CO.
GREENVILLE, S.C.

Page in NNN – 59 – 5of 9555

9555 Filed This 10 day of Oct. 19 66
And Recorded in Vol NNN Page 59 at 4:11 P.M
Ollie Farnsworth
Register Mesne Conveyance Greenville County, S. C.