
## LTGI DOOK-WANTER I 43 12

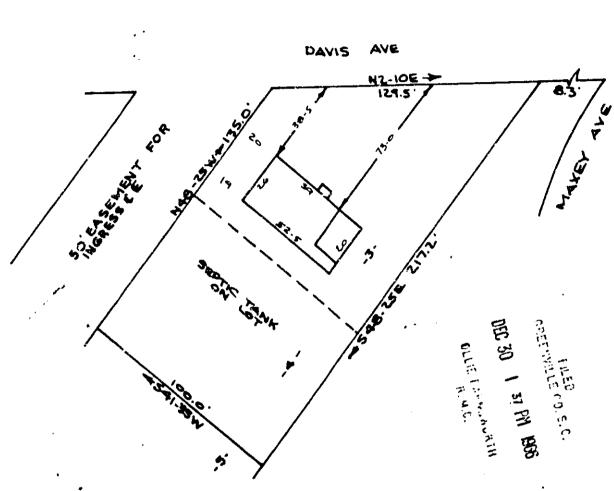

HORACE BLASSINGAME ROSA LEE BLASSINGAME
NEAR GREENVILLE, M.C.
SCALE 1240, 2988C1966

This is to certify that on the 29th day of December, 1966, I surveyed the property shown on this plat, being known as lots 3 and 4 on plat of Property of John P. Wright, and also being known as property of Horace Blassingame and Rosa Lee Blassingame, and recorded in the R.M.C. Office Greenville County, S.C. in plat book page; and that the property lines, walls and buildings are as shown hereon, and that the buildings located on said lot do not encroach or project on adjacent street or property, and that no adjacent street or walls encroach or project on said premises.

R. B. Bruce R. L. S. # 1952

CAROLINA ENGINEERING AND SURVEYING CO. GREENVILLE, S.C.

15986

NNN-143

And Recorded in Vol. ANN Fage 143., at 137P. M.

Register Mosne Consequence Greenville County, S. C.