


Plat Book-NNN-Page 146

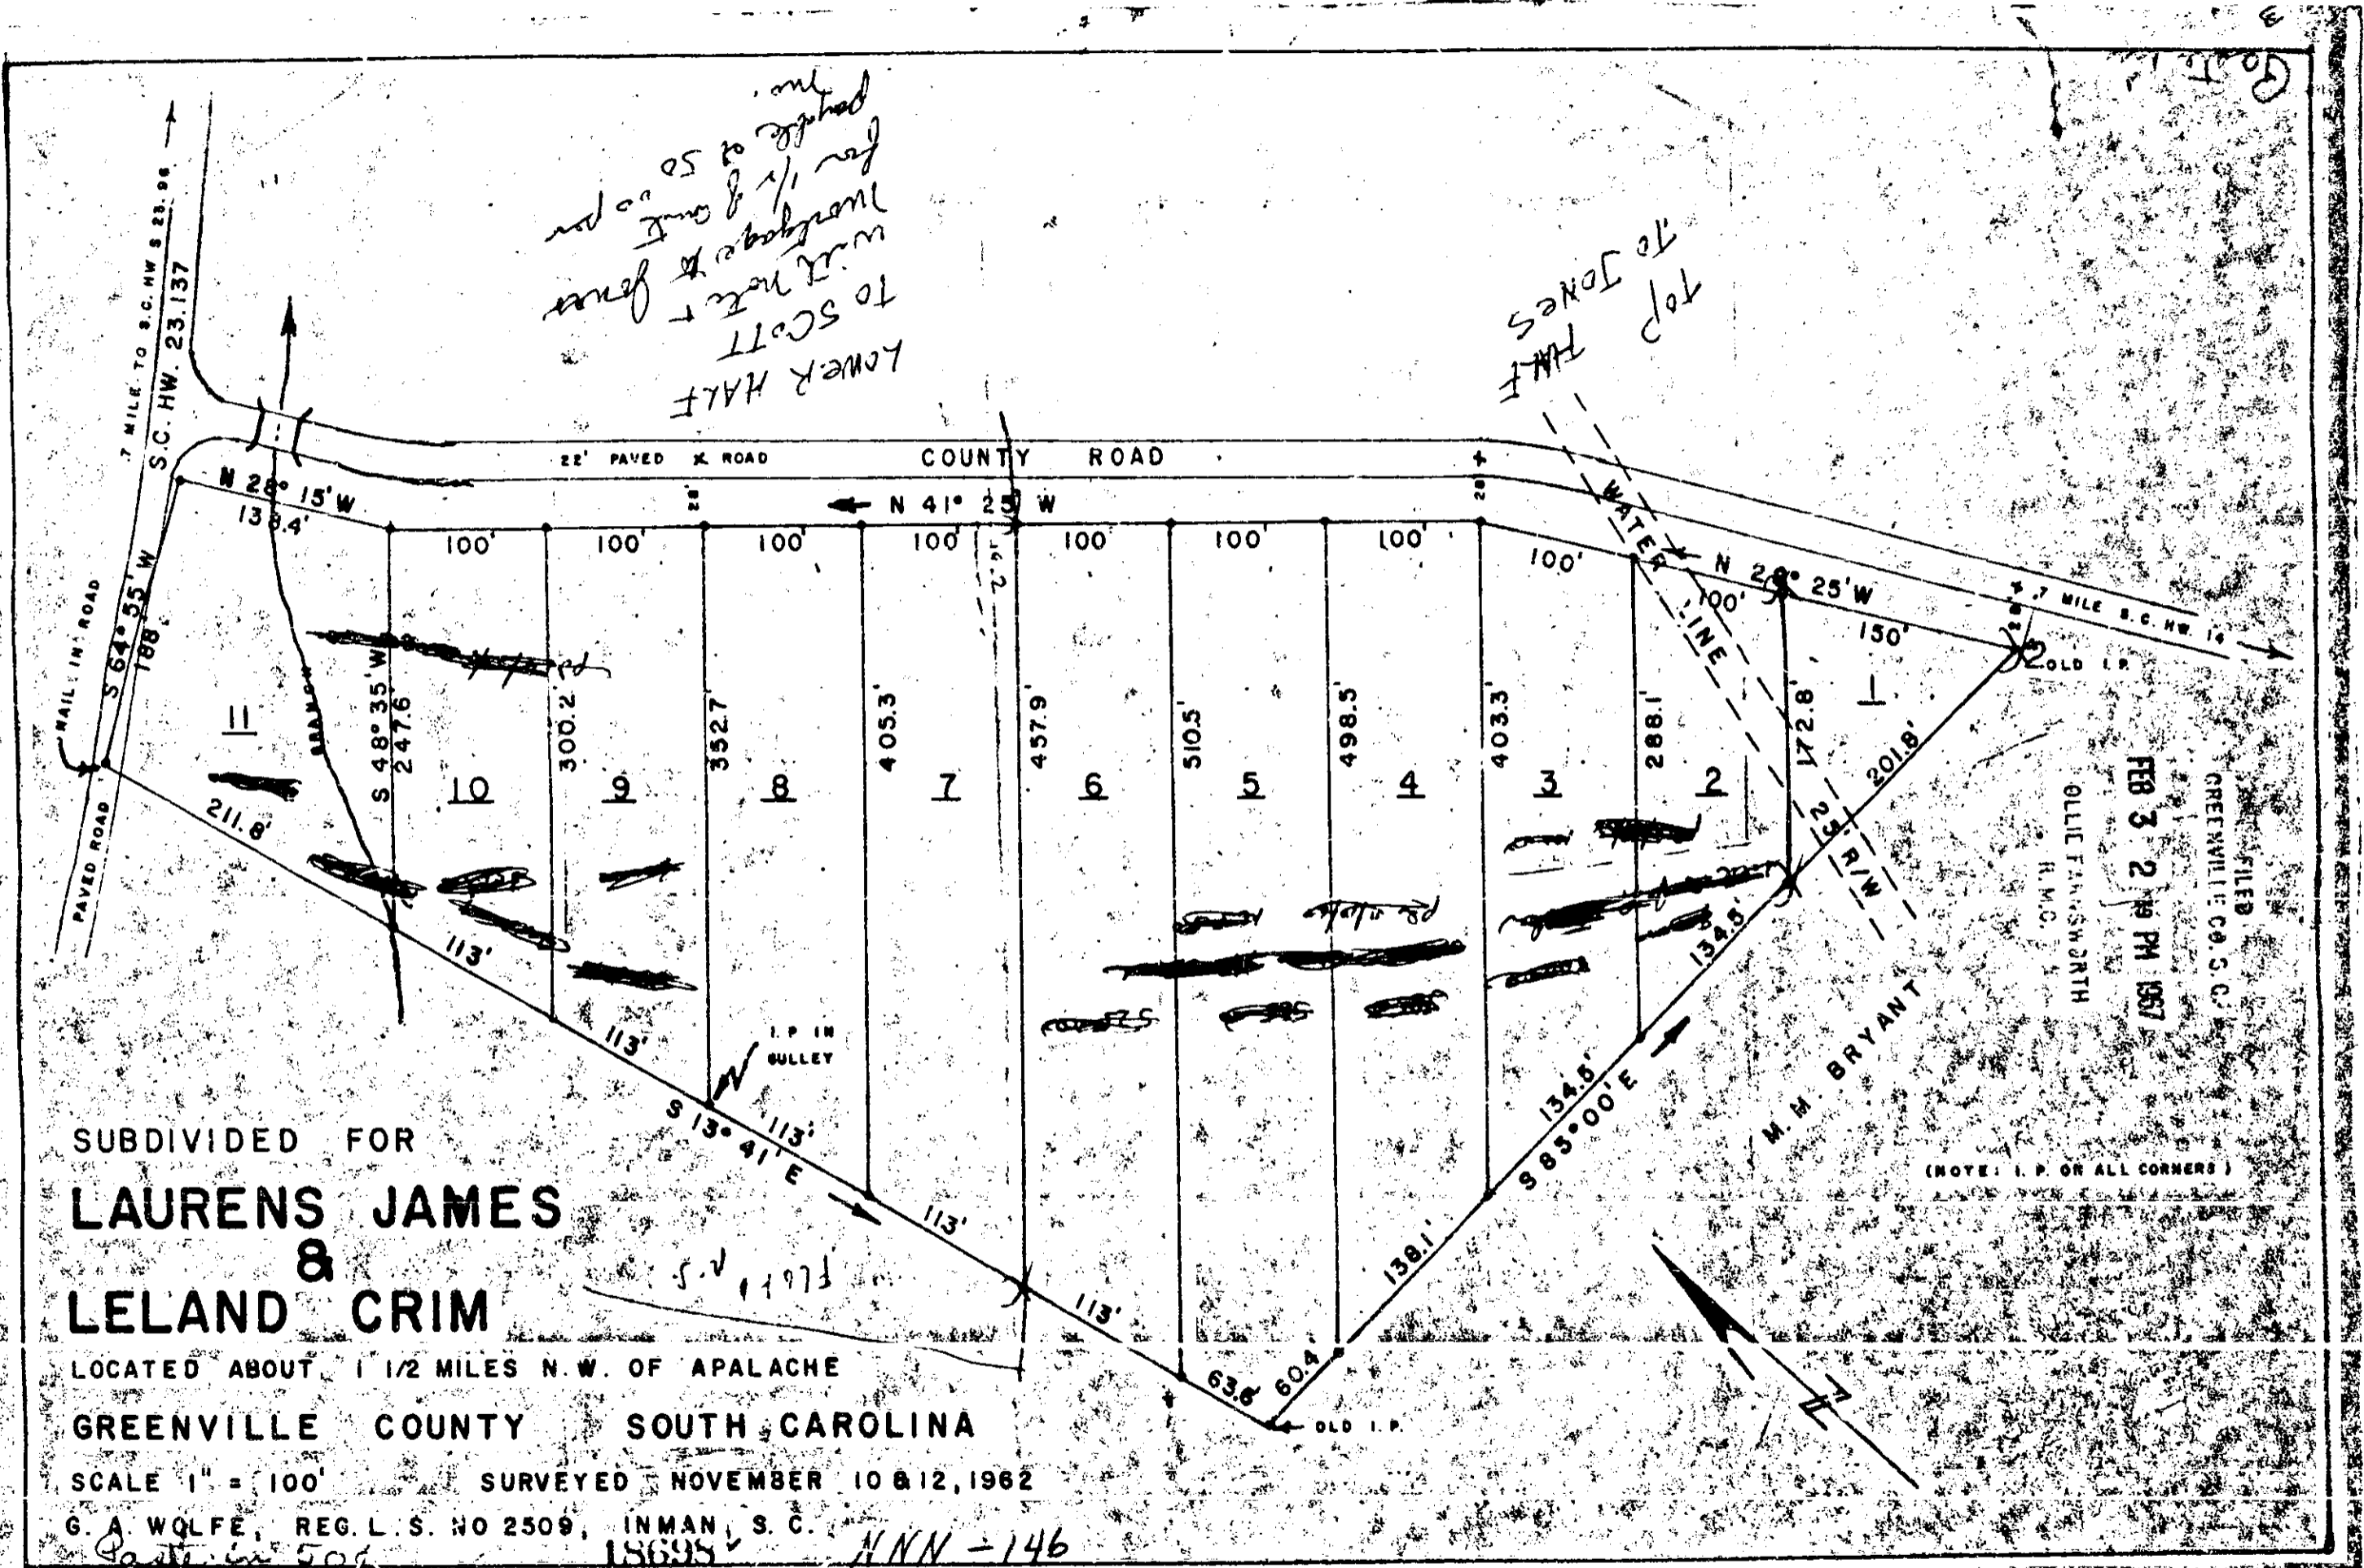

#18698 FILED 3 2 19 67
And Recorded in Vol. NNN Page 146 at 2:39 PM
Ollie Farnsworth
Register and Conveyance Greenville County, S. C.