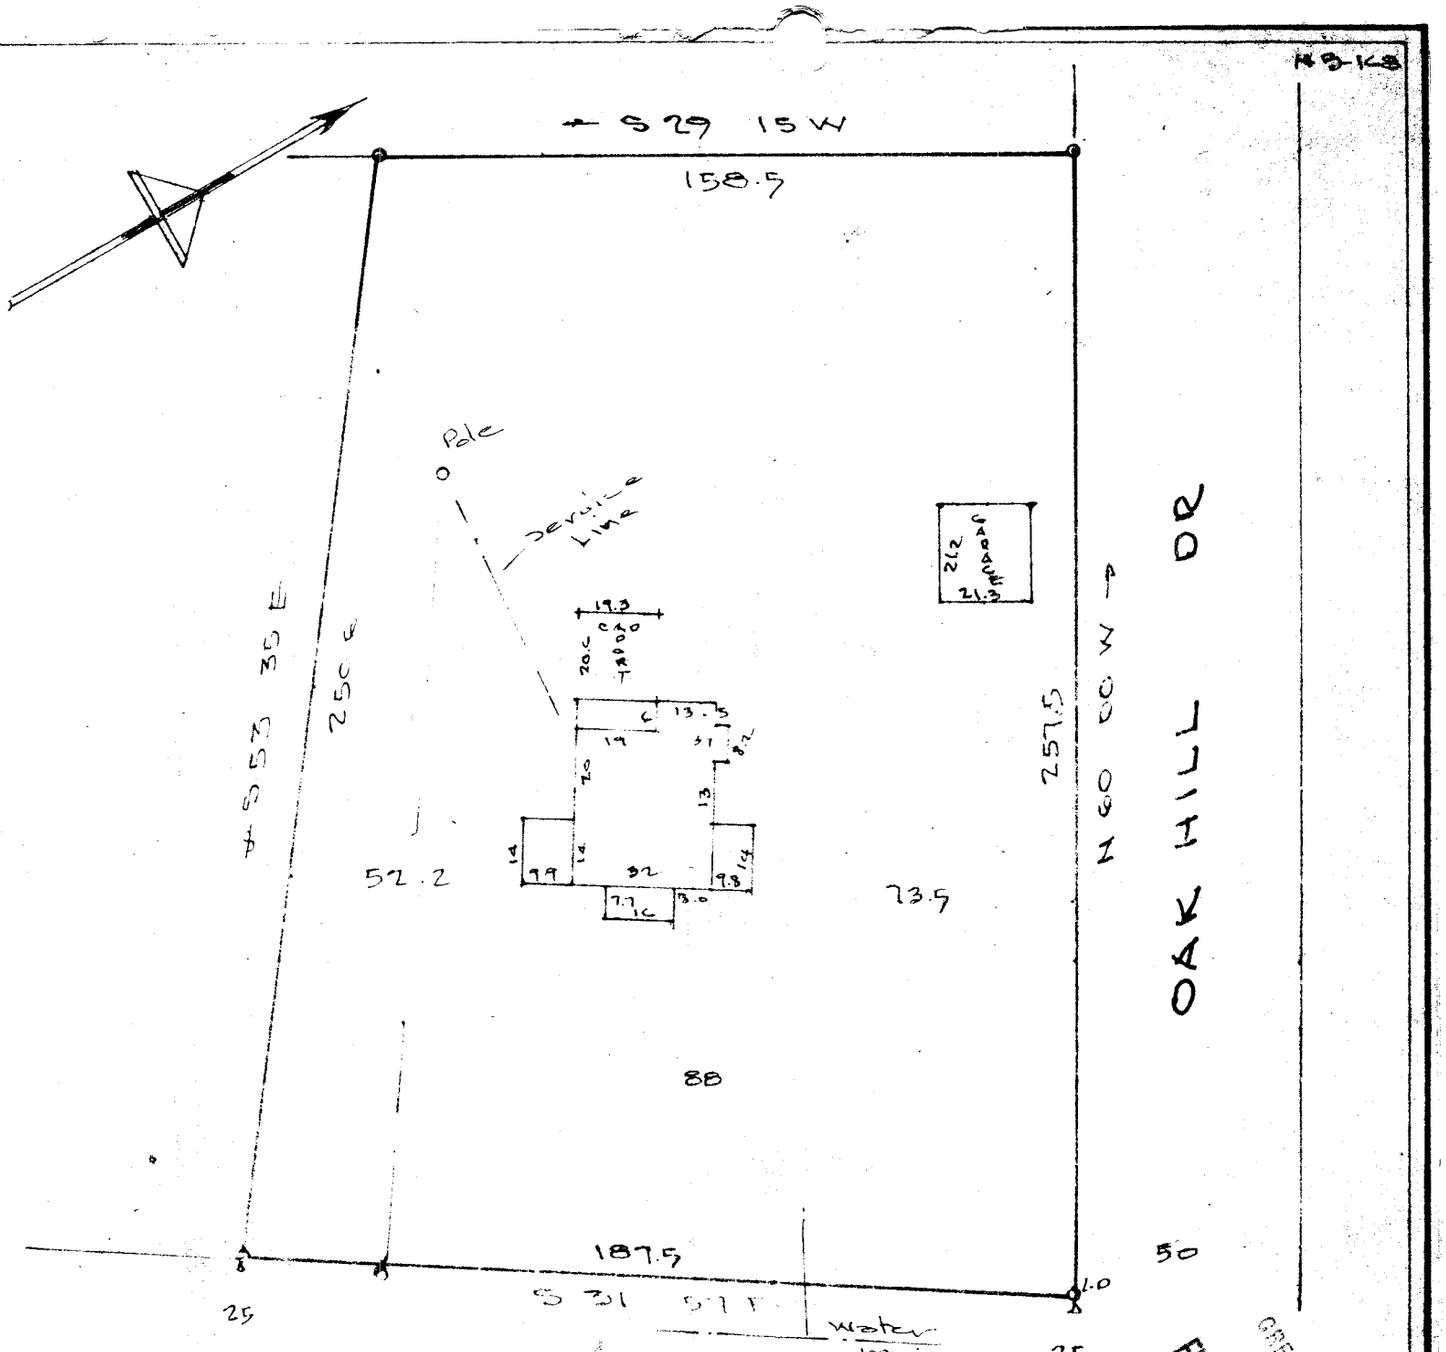

This is to certify that on the 30th day of JAN. 1967, I surveyed the property shown on this plat, being Prop. of JOSEPH C. & ELIZABETH H. HUMPHRIES, recorded in Plat Book NNN Pg 169. of the R.M.C. Office for Greenville County, S. C., and that the property lines, walls and buildings are as shown hereon; that the buildings located on said lot do not encroach or project on adjacent streets or property; and that no adjacent buildings or walls encroach or project on said premises, and that no utility lines cross this property.

Reg. Engineer No. 1144 S.C.
JONES ENGINEERING SERVICES- GREENVILLE S.

PROPERTY OF

JOSEPH C. HUMPHRIES
AND
ELIZABETH H. HUMPHRIES

GREENVILLE COUNTY, S.C

SCALE 1"=40' JAN 30 1967

18986

NNN-169.

#18986 Filed This 8th day of Feb. 1967
And Recorded in Vol. NNN Page 169 at 12:59 P. M
Ollie Farnsworth
Register Mesne Conveyance Greenville County, S. C.