


Plat Book-PPP-Page 99B

FILED
GREENVILLE S.C.
APR 27 3 49 PM 1967
OLLIE FARMWORTH
S.V.C.

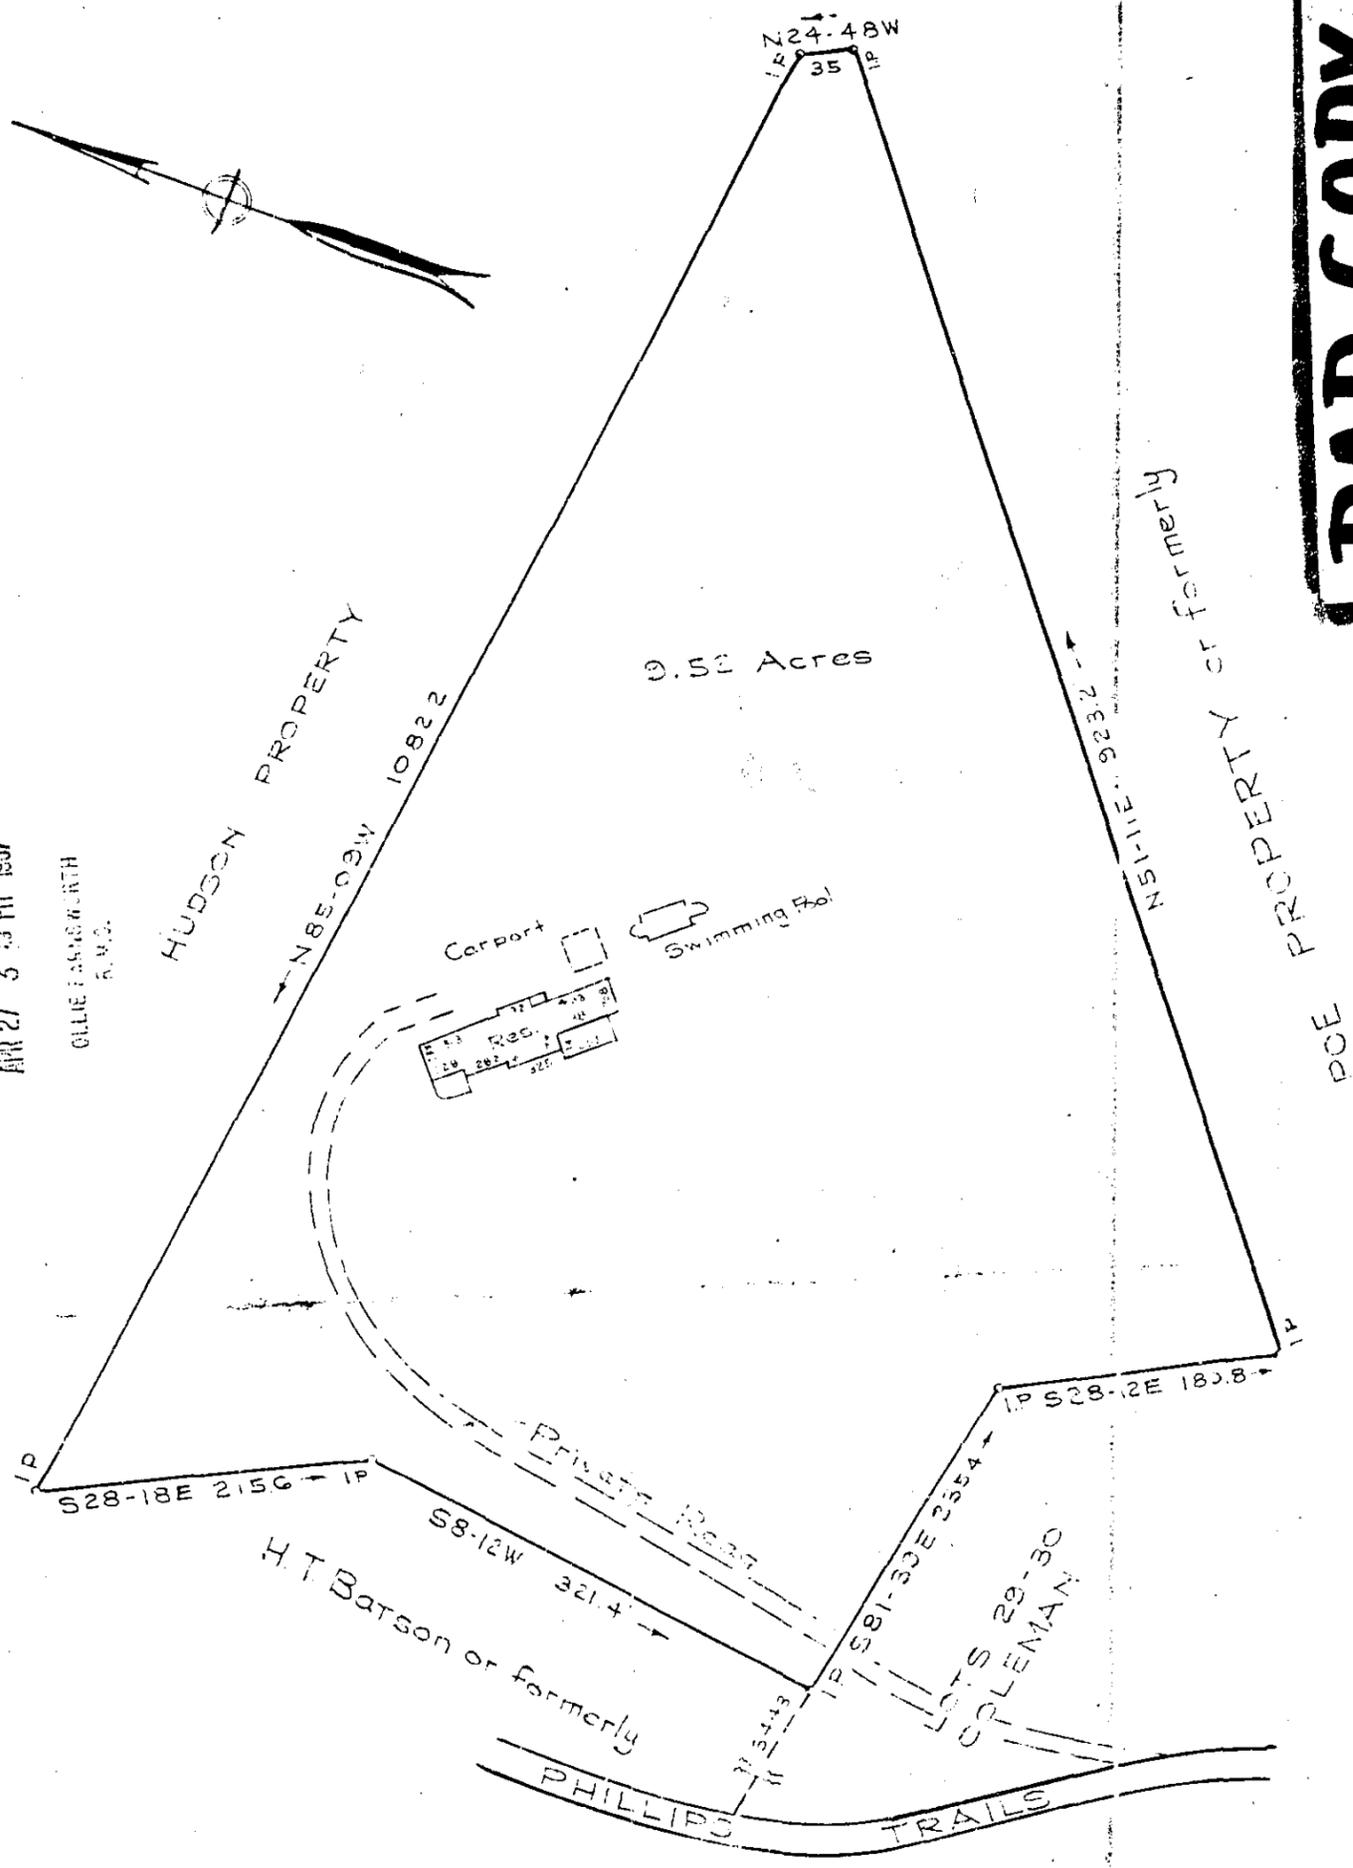

BAD COPY

PROPERTY OF
JANE H. COLEMAN
GREENVILLE CO. S.C.
Scale 1"=100' April 1967

This is to certify that on the 17th day of April, 1967, I surveyed the property shown on this plat; and that the property lines, walls and buildings are as shown hereon; that the buildings located on said property do not encroach or project on adjacent streets or property; and that no adjacent buildings or walls encroach or project on said premises.

R. W. Dalton
DALTON & NEVES, ENGINEERS.

26014

370 Paste in 125 PPP-99

#26014 INDEXED 27th of April 1967
And Recorded in PPP-99 at 3:49 PM
Ollie Farmworth

66