FILED
GREENVILLE CO. S. C.

APR 18 2 59 PM 1967

OLLIE FARNSWORTH
R. M. C.

NOTE:
COMPILED FROM
EXISTING PLATS.

THIS IS A PLAT OF CORRECTION TO ESTABLISH STREET RIGHT-OF-WAY LIMITS ON CUL-DE-SAC PORTION OF KNOXBURY TERRACE AND IS AGREED TO AND APPROVED BY THE EFFECTED PROP. OWNERS

APPROVED

E. M. [illegible]
OWNER OF LOTS # 3 & 4

[illegible]
OWNER OF LOT # 5

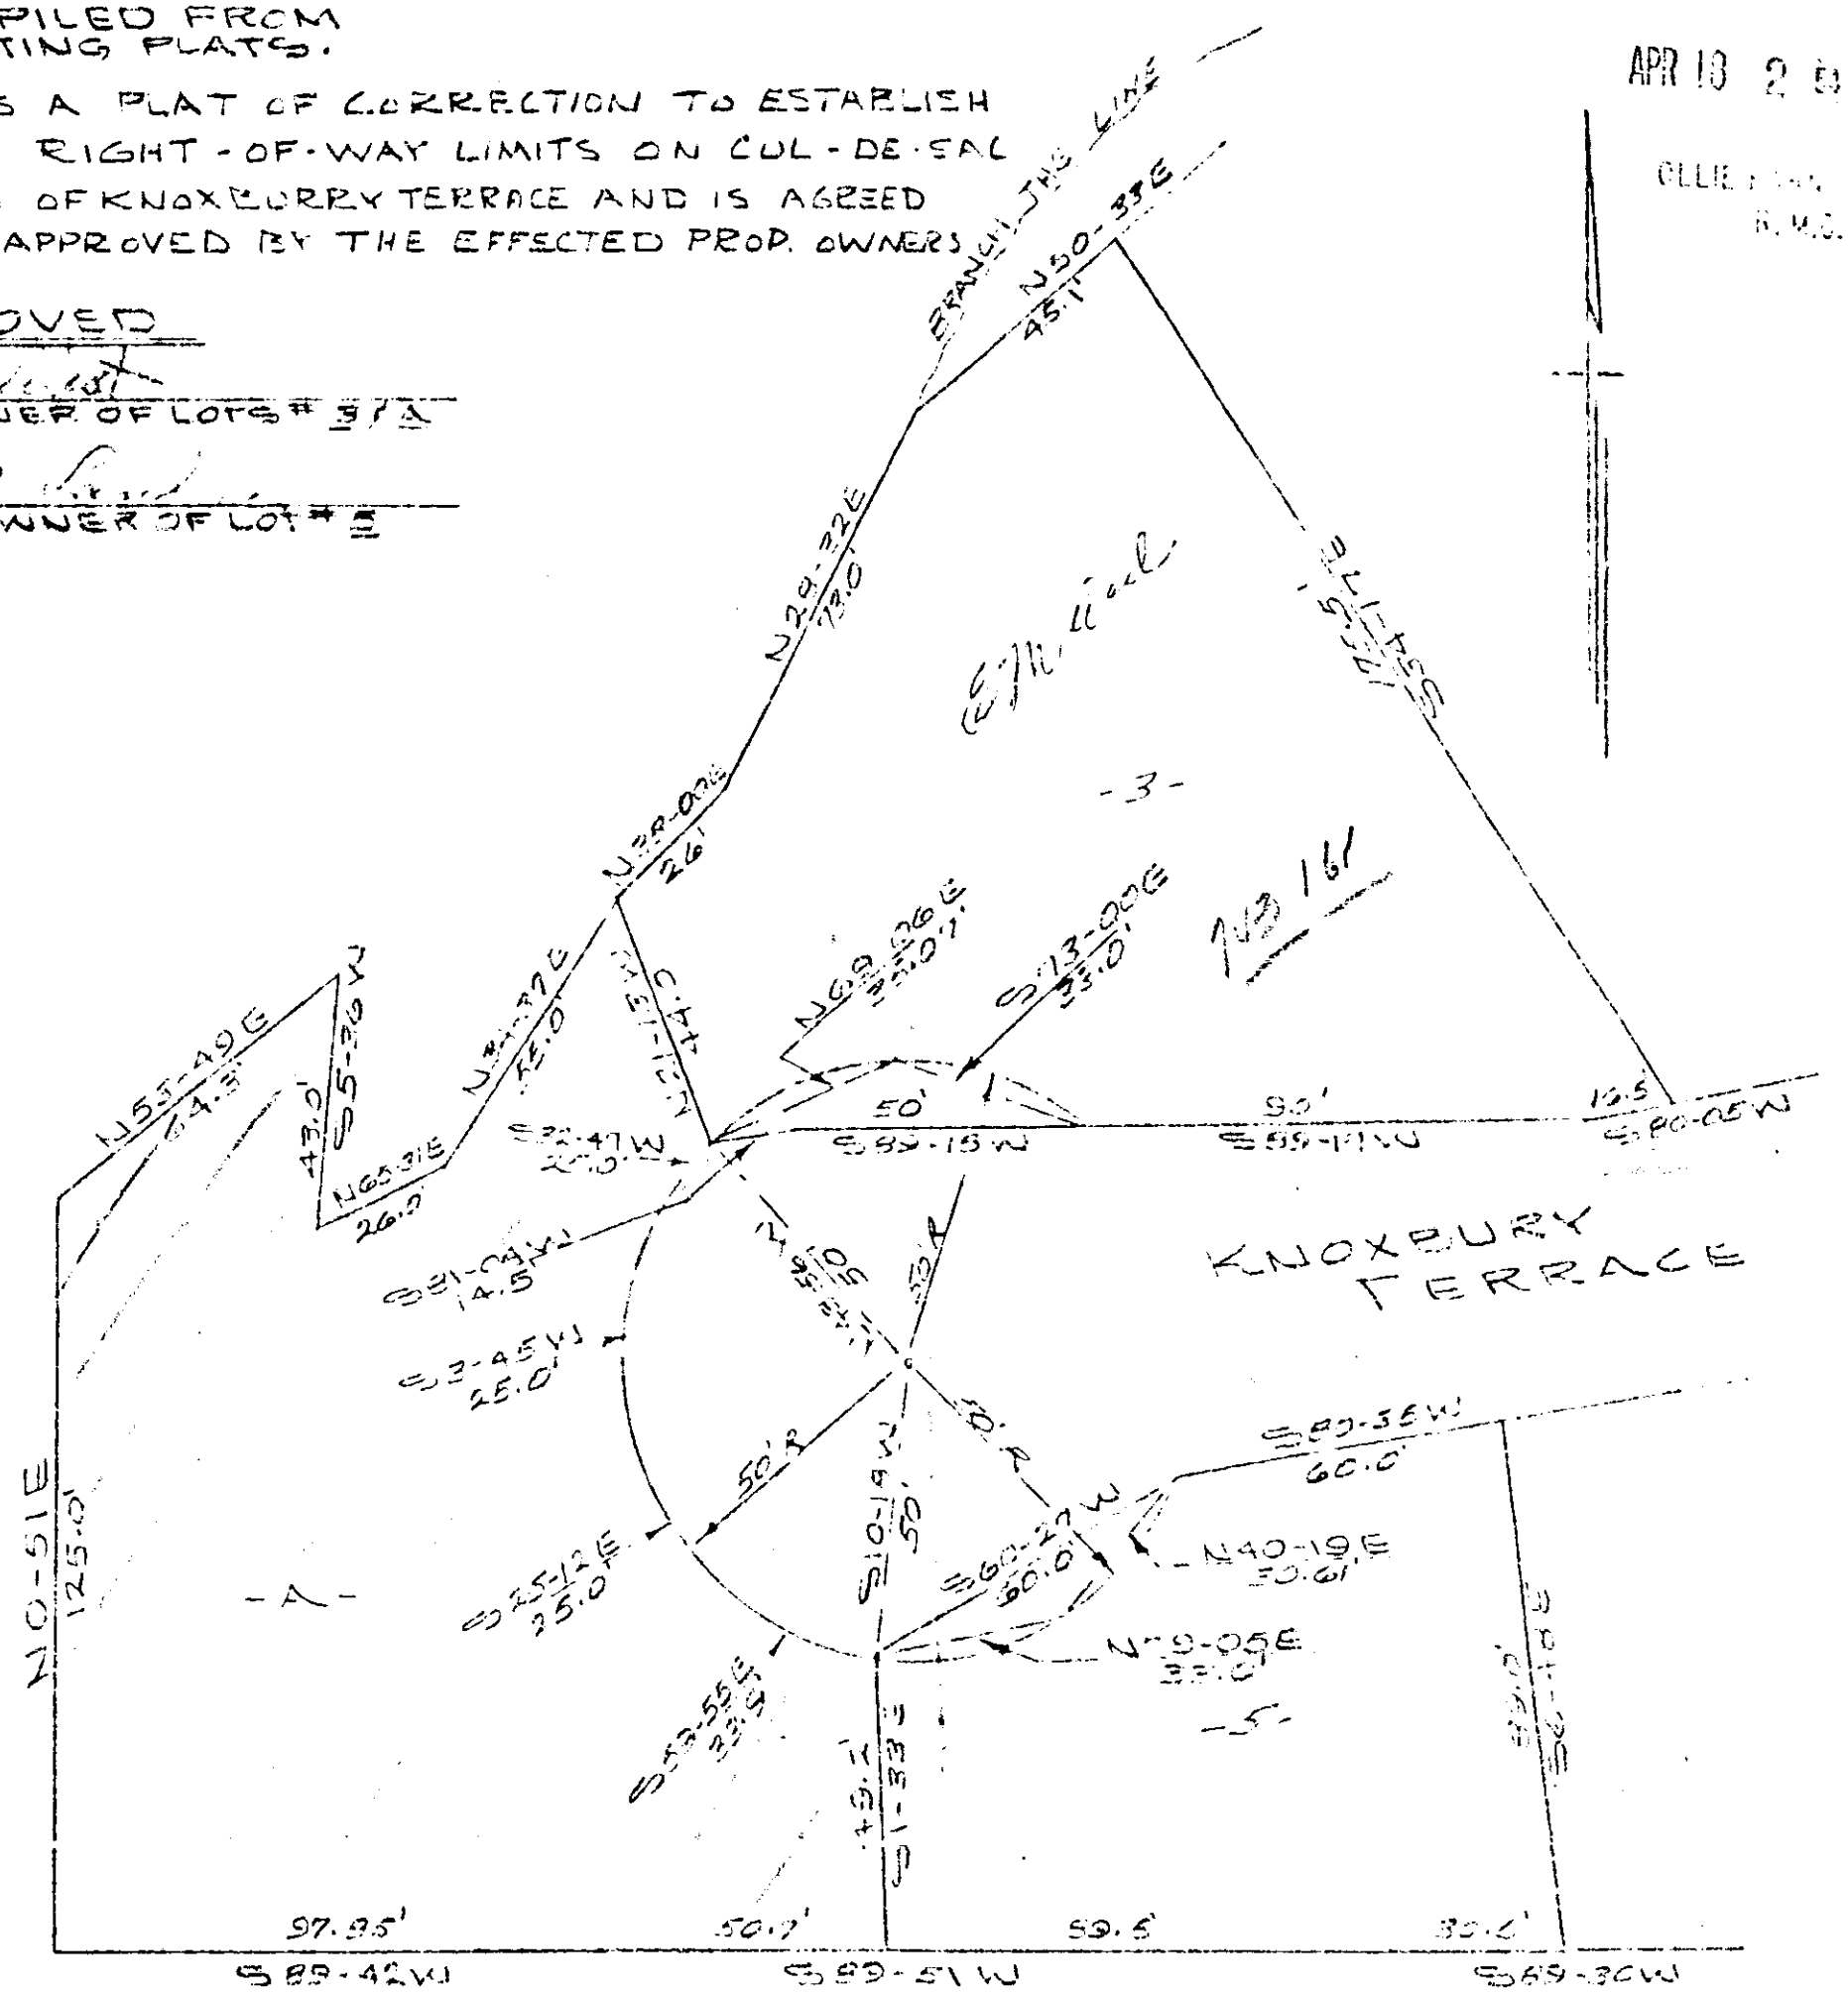

REVISION OF
KNOXBURY TERRACE CUL-DE-SAC
GREENVILLE, S.C.
SCALE 1"=40' JAN. 31, 1967

Sec 1 00

QQQ-95 25182

PIEDMONT ENGINEERS & ARCHITECTS
GREENVILLE, S. C.

#25182 Filed This 18th day of April 1967
And Recorded In Vol. 666 Page 95 at 2:59 P.M.
Ollie Farnsworth
Register Mesne Conveyance Greenville County, S. C.