


SULLIVAN HARDWARE CO.

FILED
GREENVILLE CO. S. C.

MAY 16 9 44 AM 1967

OLLIE FARNSWORTH
R. M. O.

ENGINEERED PLASTICS, INC.

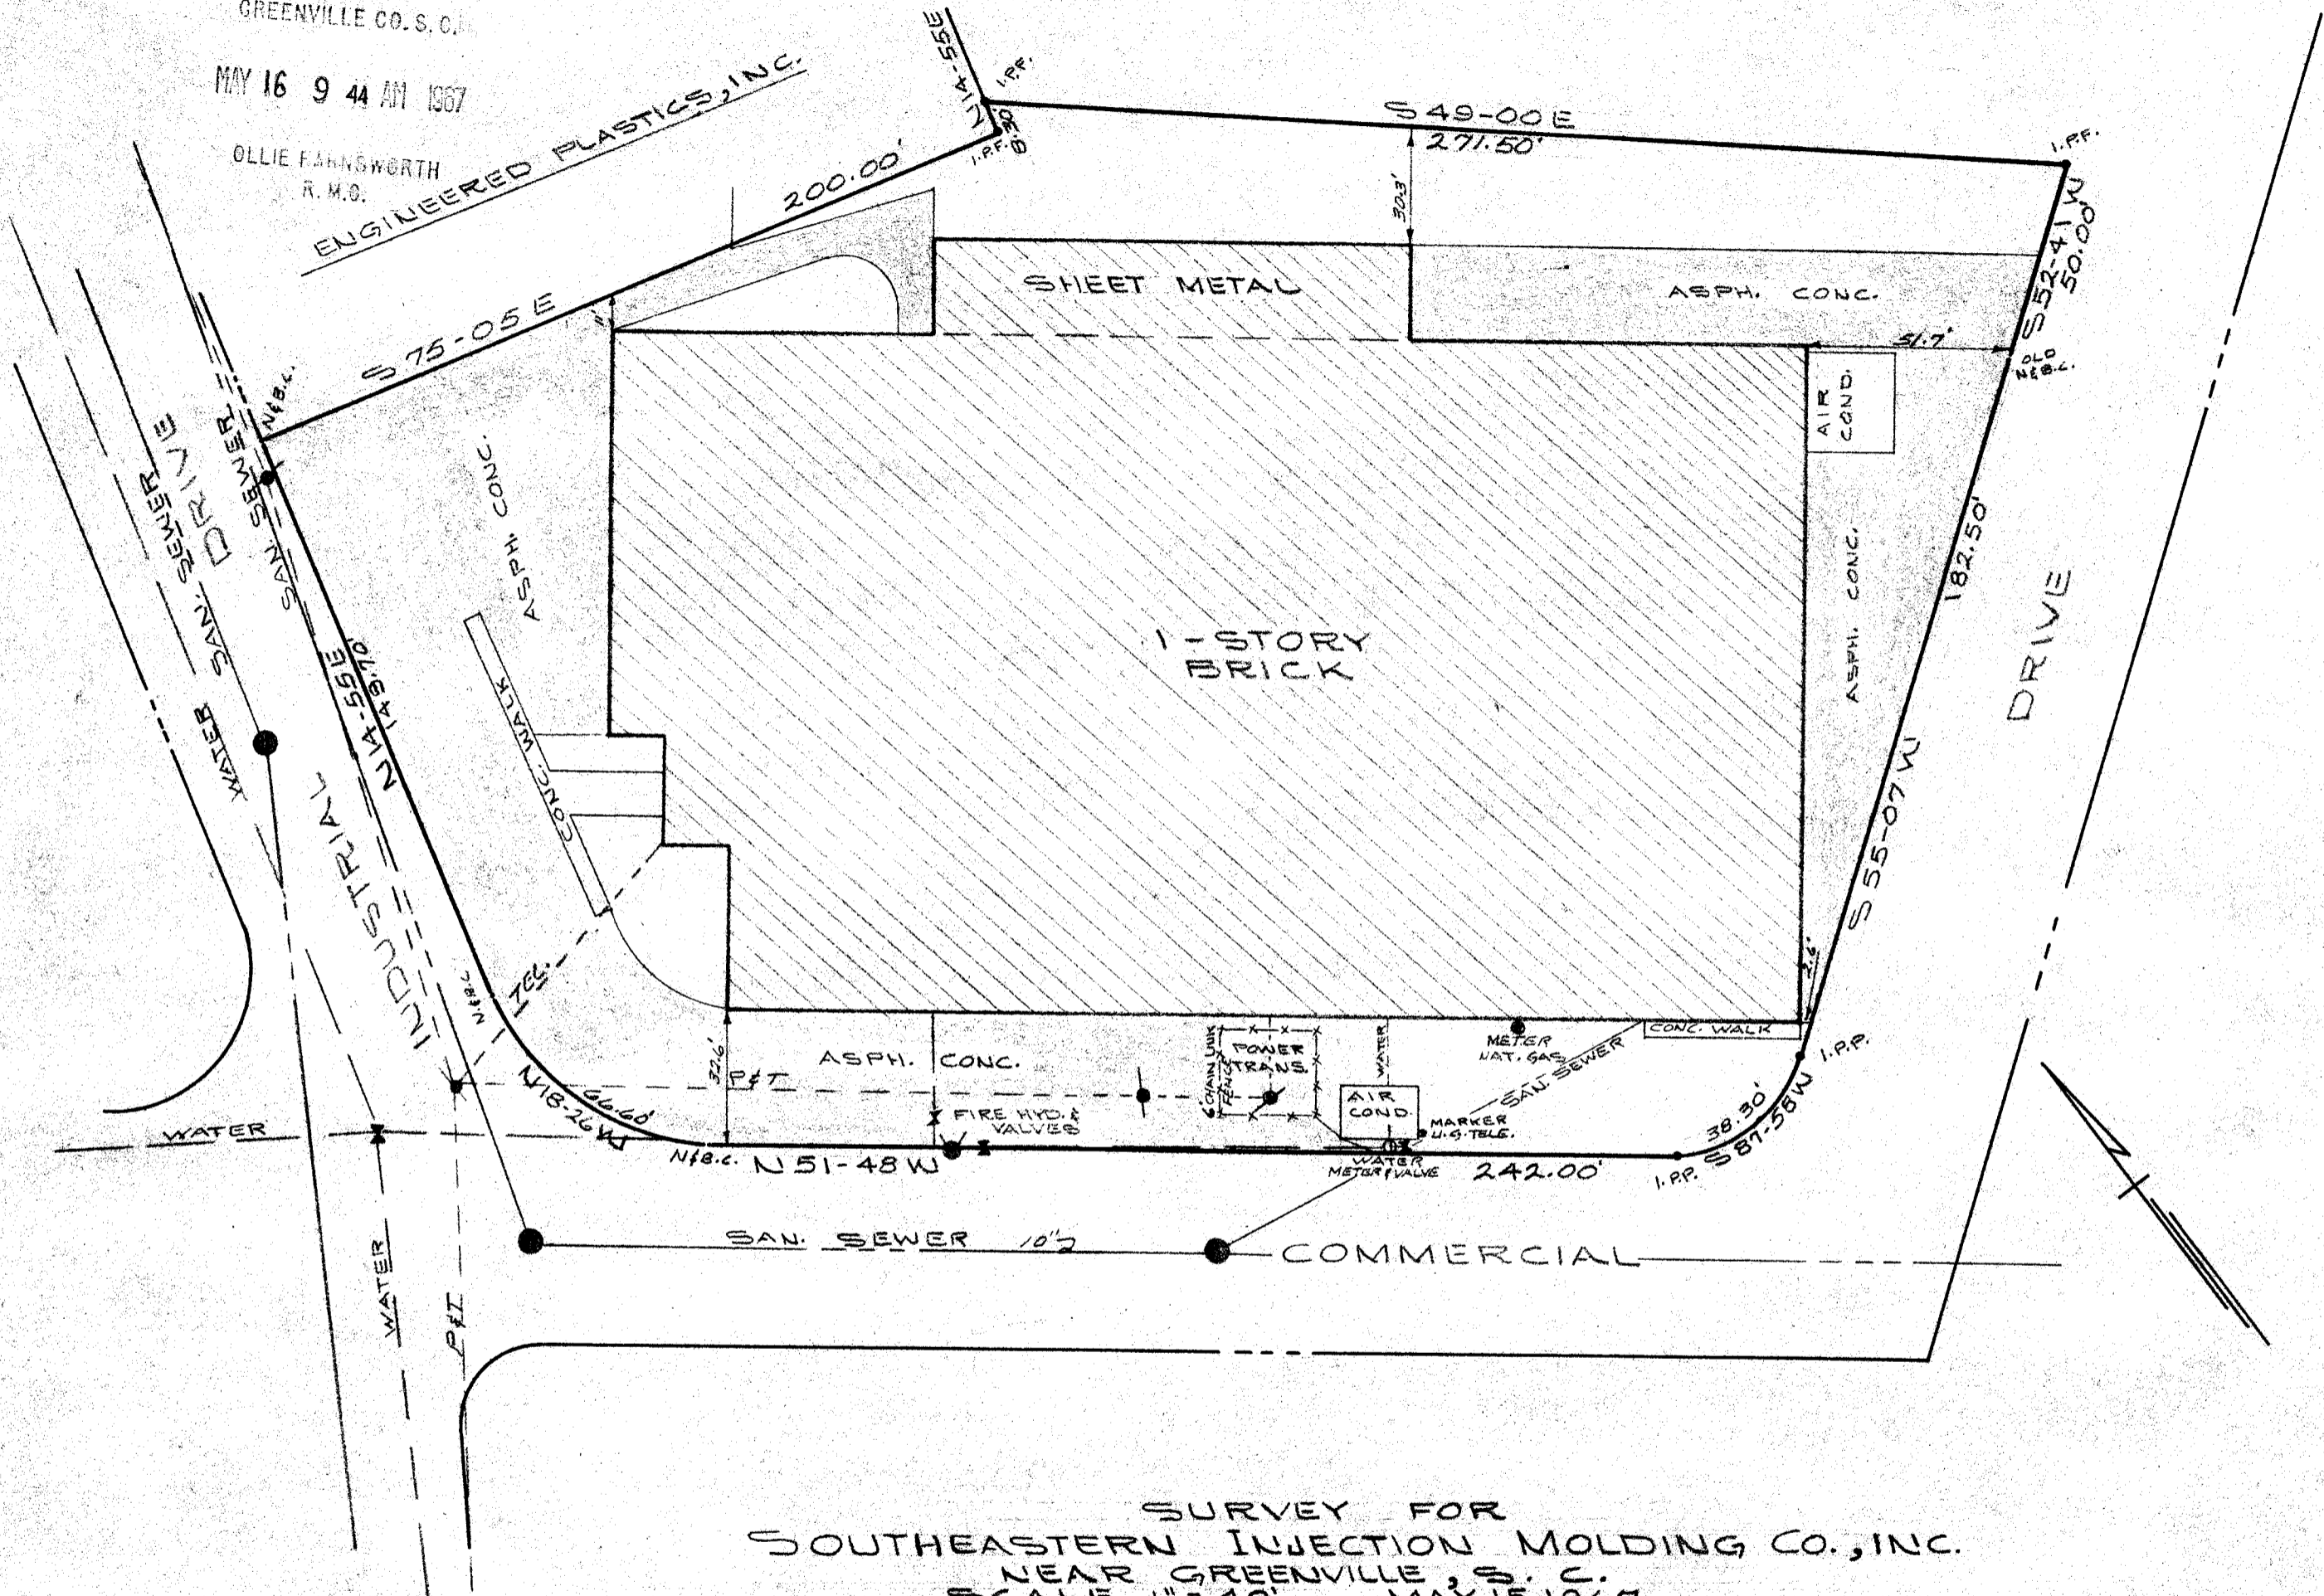

SURVEY FOR
SOUTHEASTERN INJECTION MOLDING CO., INC.
NEAR GREENVILLE, S. C.
SCALE 1" = 40' MAY 15, 1967

PIEDMONT ENGINEERS & ARCHITECTS
GREENVILLE, SOUTH CARO.

1.00
27845
QQQ-131

#27845 Filed This 16th day of May 19 67
And Recorded in Vol. QQQ Page 131 at 9:44 AM
Ollie Farnsworth
Register Merne Conveyance Greenville County, S. C.