


Plat Book RRR Page 63 B

63

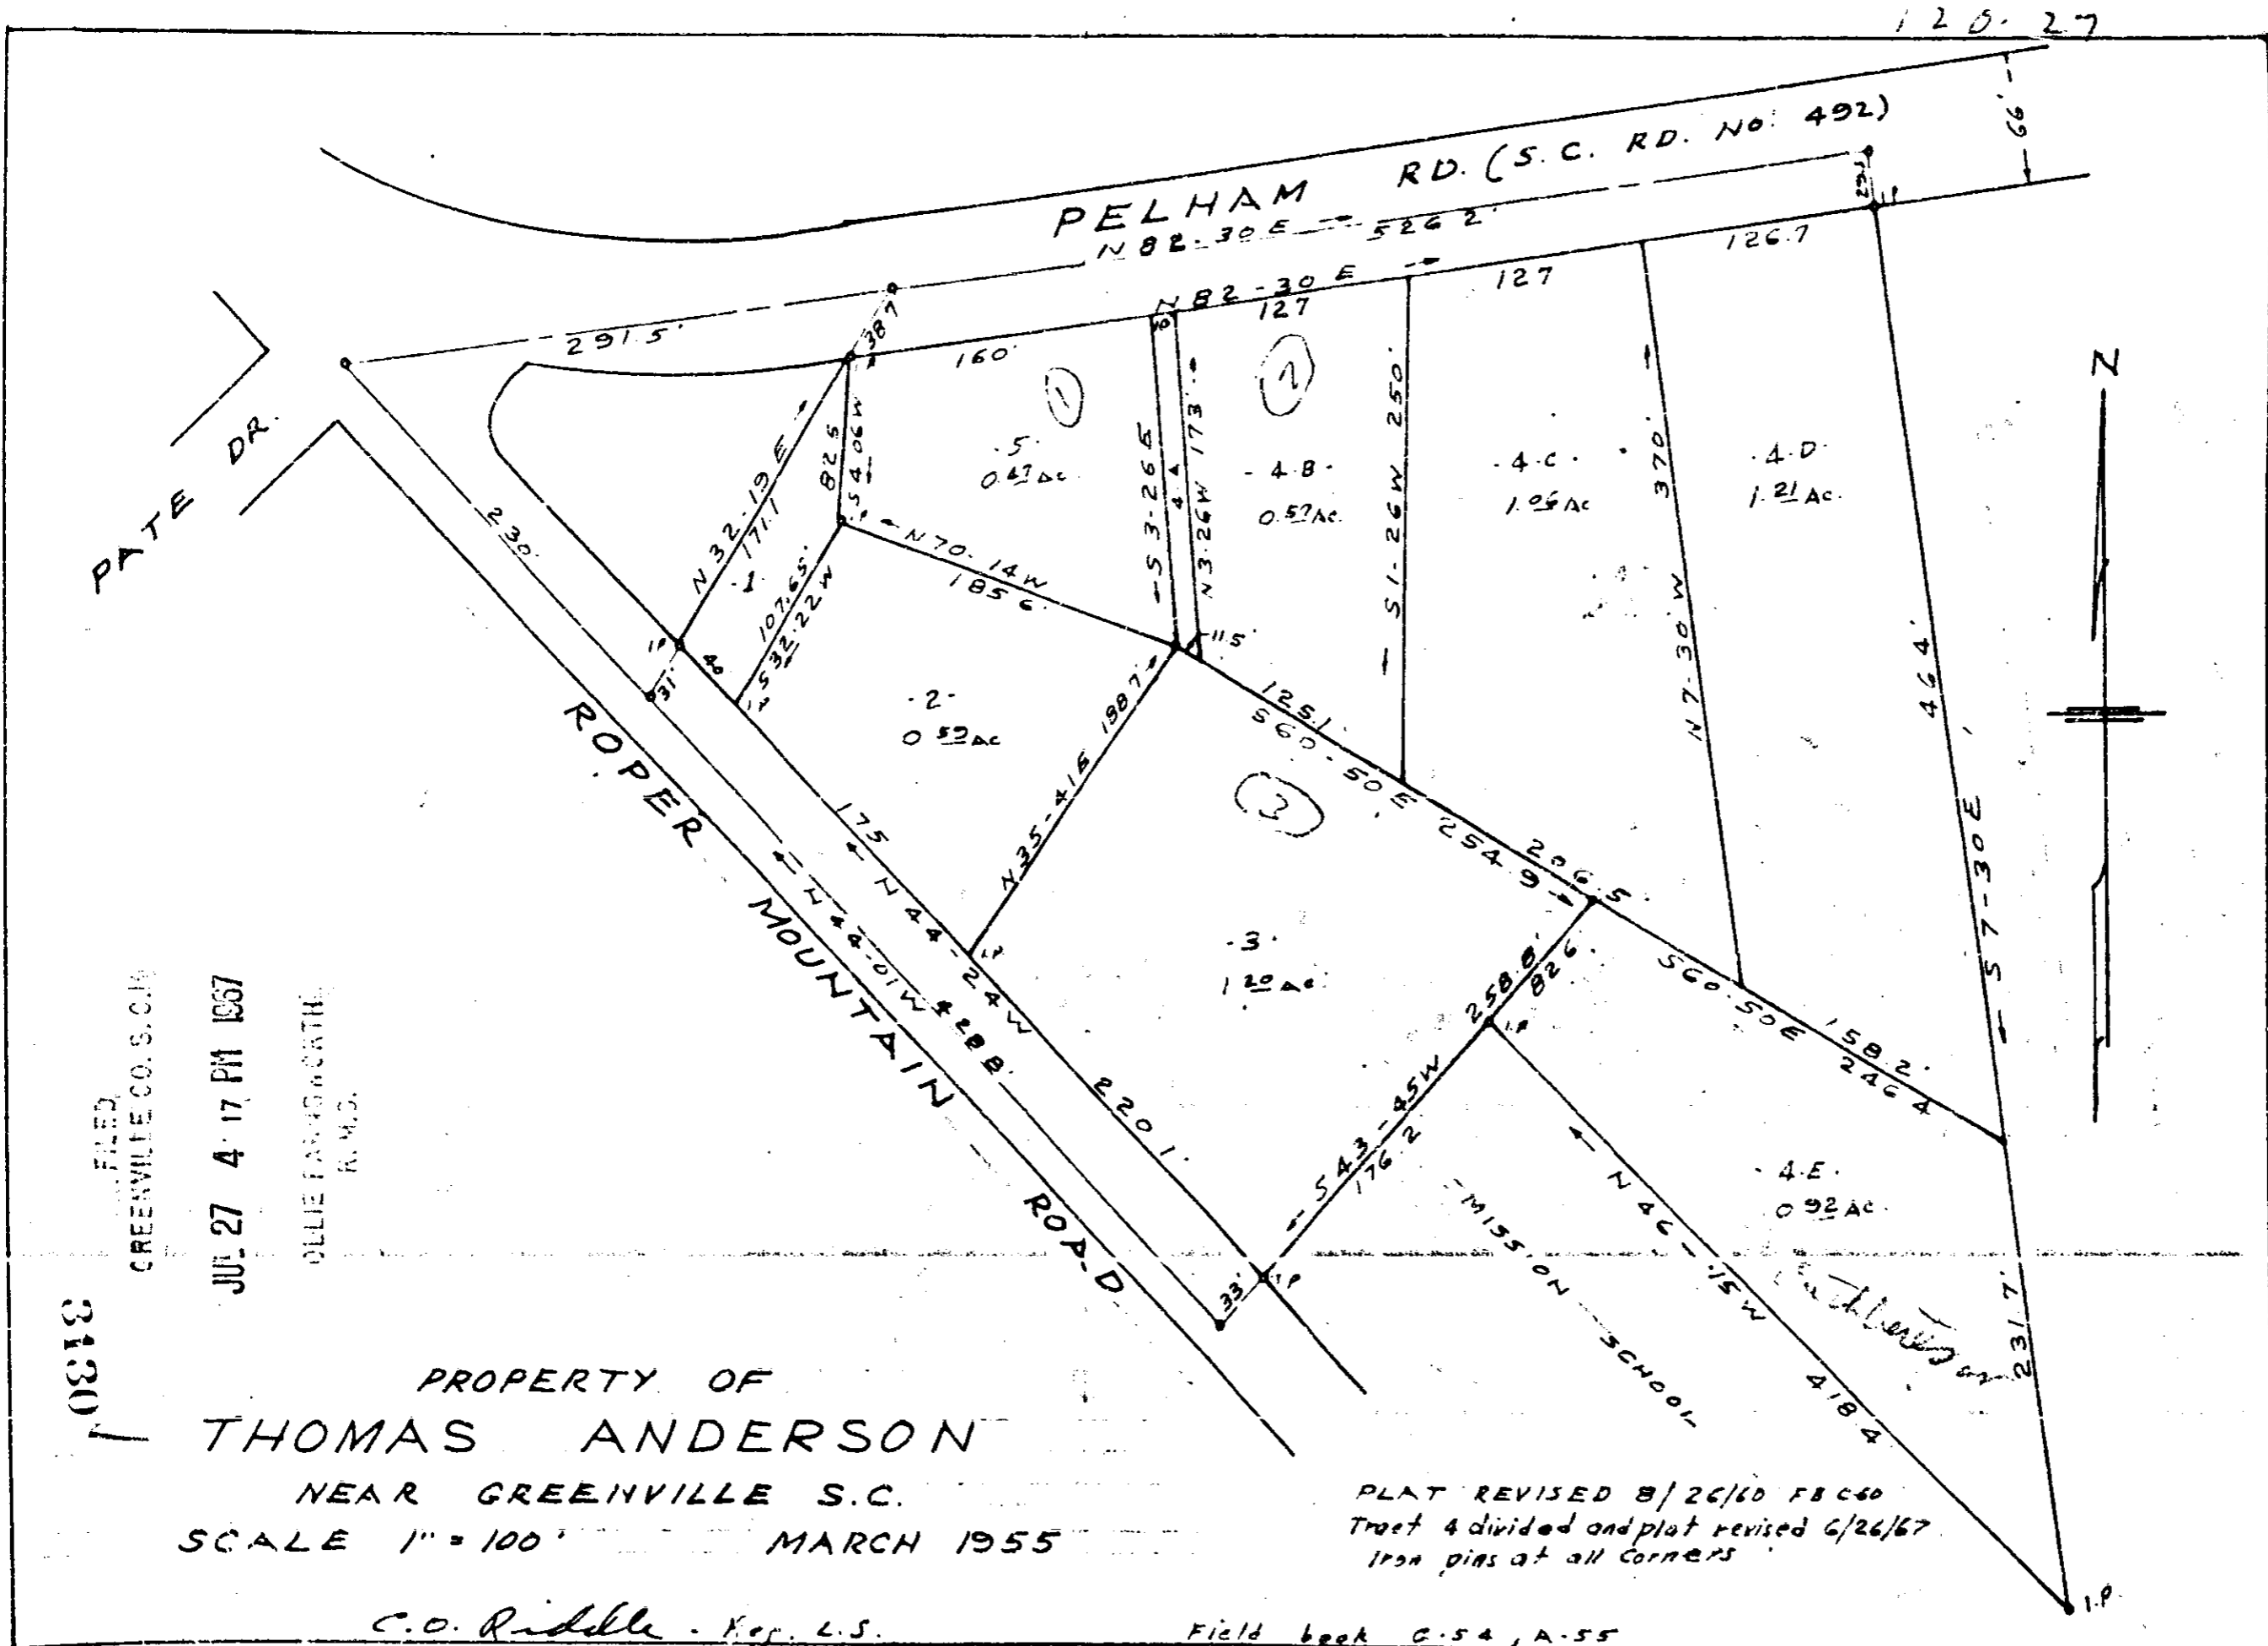

FILED
GREENVILLE CO. S.C.
JUL 27 4 17 PM 1957
DOLLIE FAY GORTON
R.M.D.

At 3:30 P.M. Filed This 27 day of July 19 1957
And Recorded in Vol. R.R.R. Page 63 of 112 N.M.
Miss. J. J. McLaughlin
Register Mesne Conveyance Greenville County, S. C.

3130

50f R.R.R. 63