


Plat Book SSS Page 81

SSS-81

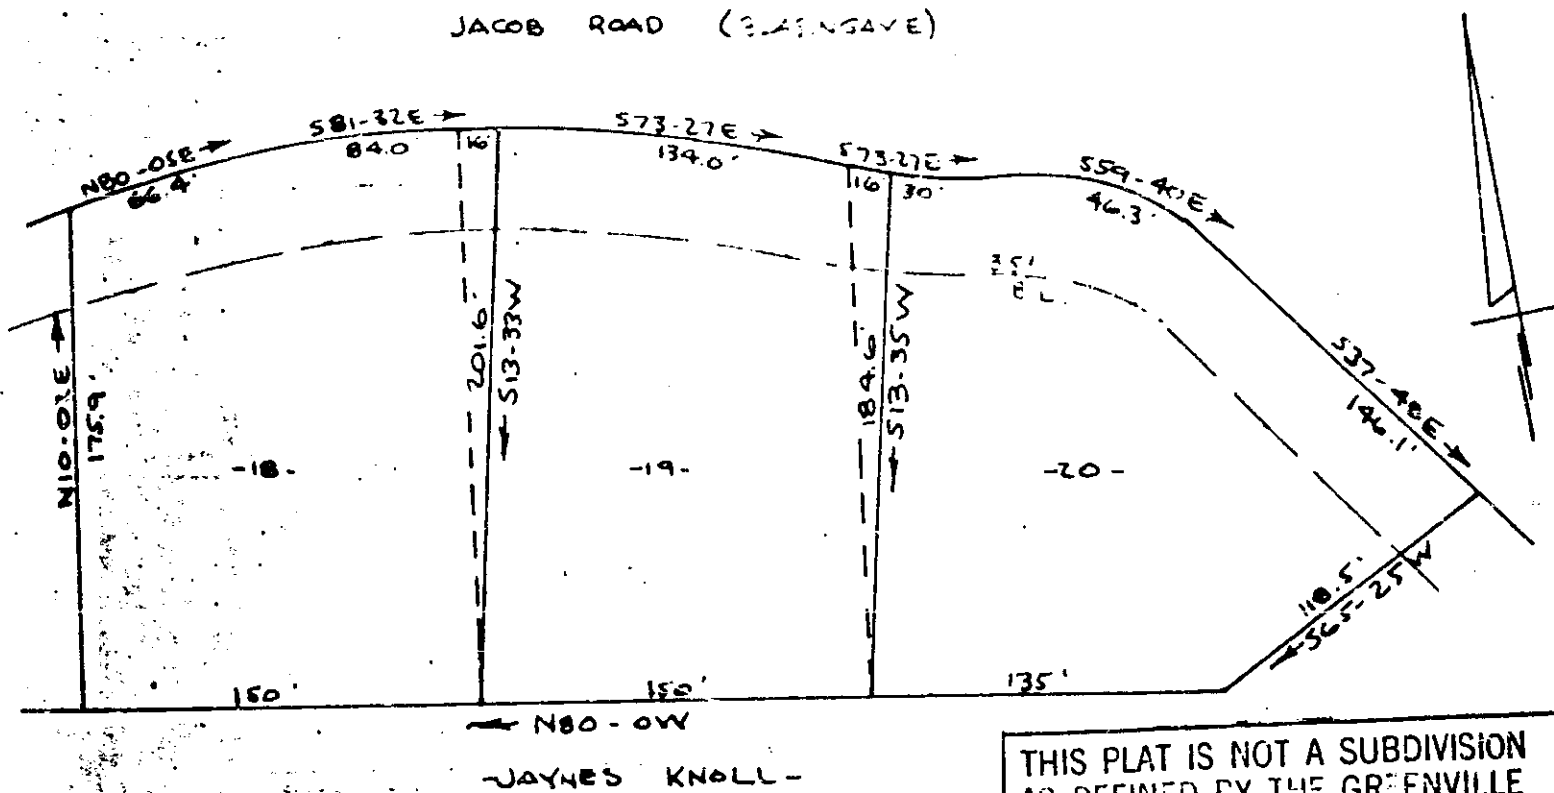

THIS PLAT IS NOT A SUBDIVISION
AS DEFINED BY THE GREENVILLE
COUNTY SUBDIVISION REGULATIONS.

JUN 6 1968

Anthony J. Bantz
Chairman, Greenville County Director of
Planning
Greenville County Planning Commission

REVISION OF LOTS 18, 19, & 20
JAYNES KNOLL
NEAR GREENVILLE, S.C.
SCALE 1" = 60' 3 JUNE 1968

The purpose for recordation of this plat is to show the side lot lines of lots 18-19-20 being moved eastward. This original plat is recorded in Plat Book RRR page 17 on 4/3/67.

SSS-81
31610 CAROLINA ENGINEERING & SURVEYING CO.
GREENVILLE, S.C.

JUL 6 10 30 AM 1968

ORIGINAL PLAT

Recorded June 6, 1968 at 10:30 A. M., #31640.