


SSS-136

SSS-136

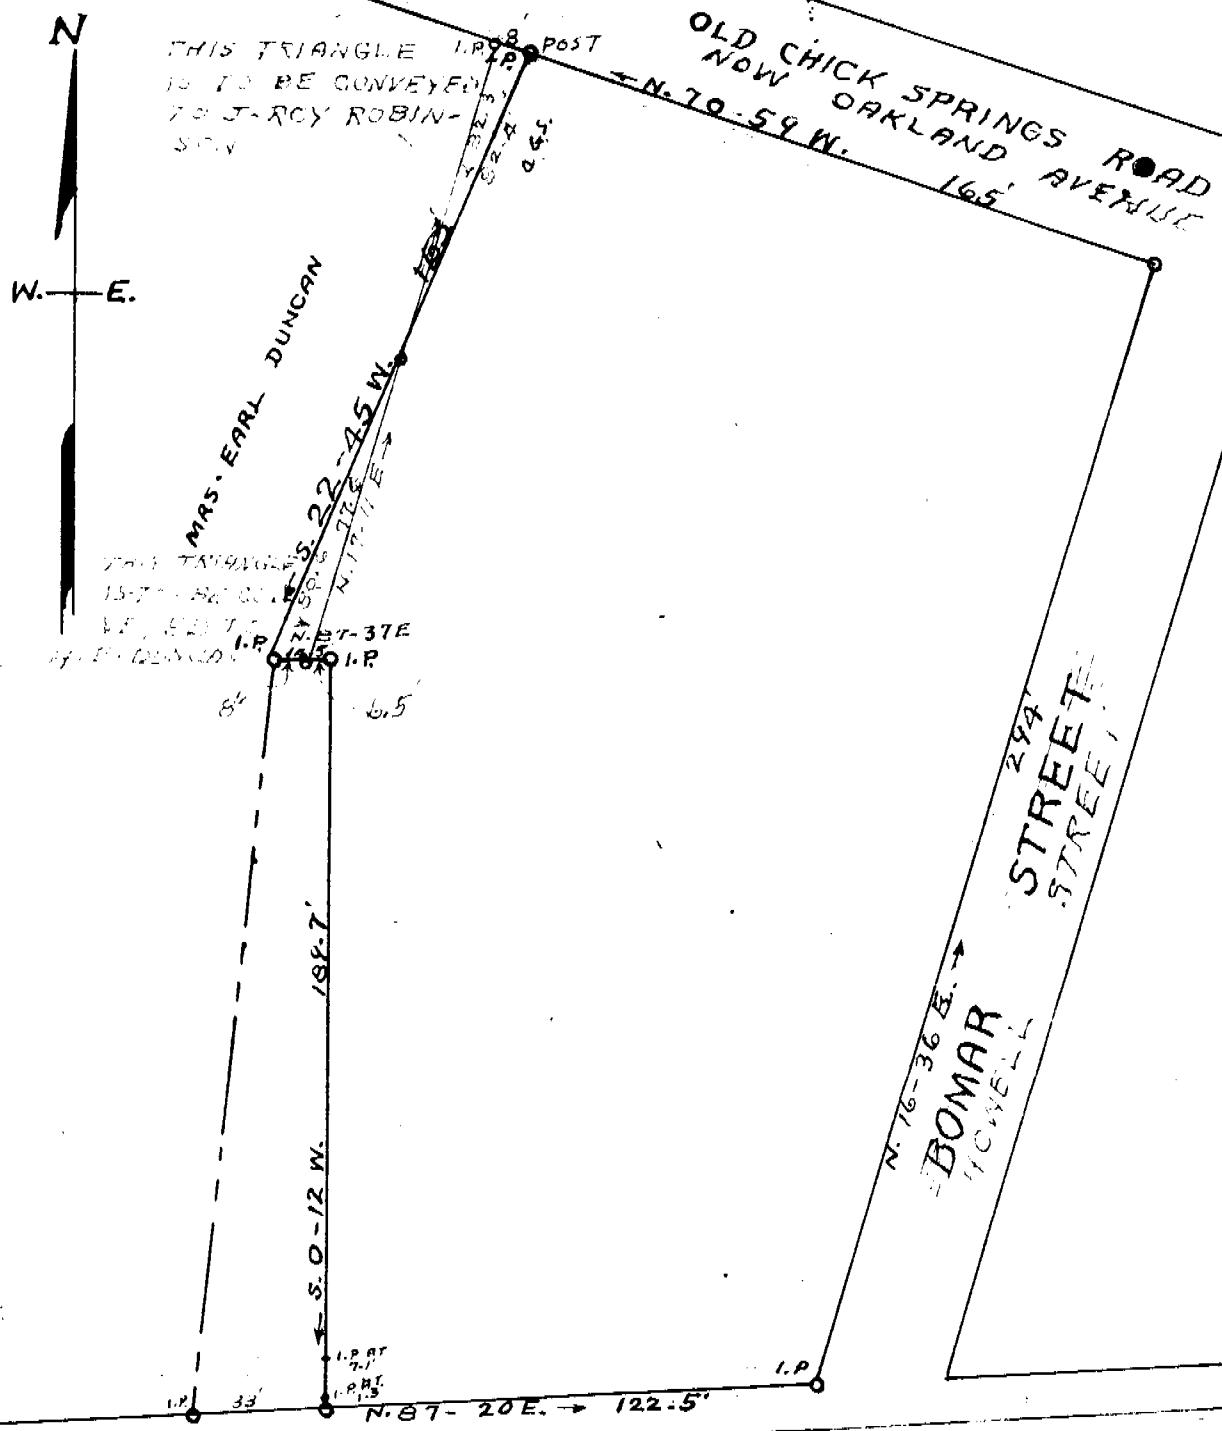

WEST POINSETT DRIVE

PROPERTY OF

MARTHA G CALDWELL

LOCATED IN NEW CITY LIMITS OF GREER, S.C.

CHICK SPRINGS TOWNSHIP, GREENVILLE COUNTY,

SOUTH CAROLINA

SCALE: 1" = .40 FEET APRIL 24 1952

PLAN AMENDED

SURVEYED APRIL 23 1952

REC'D 14-7-55

SHOWING FIELD

TRIANGLES

1.00

Rat.

NOV 26 1968

12899

H. S. BROCKMAN, REG SURVEYOR  
GREEN, S.C. - NO. 959

Recorded Nov. 26, 1968 at 9115 A. E., Greenville.

288  
12