


# Plat Book SSS Page 232

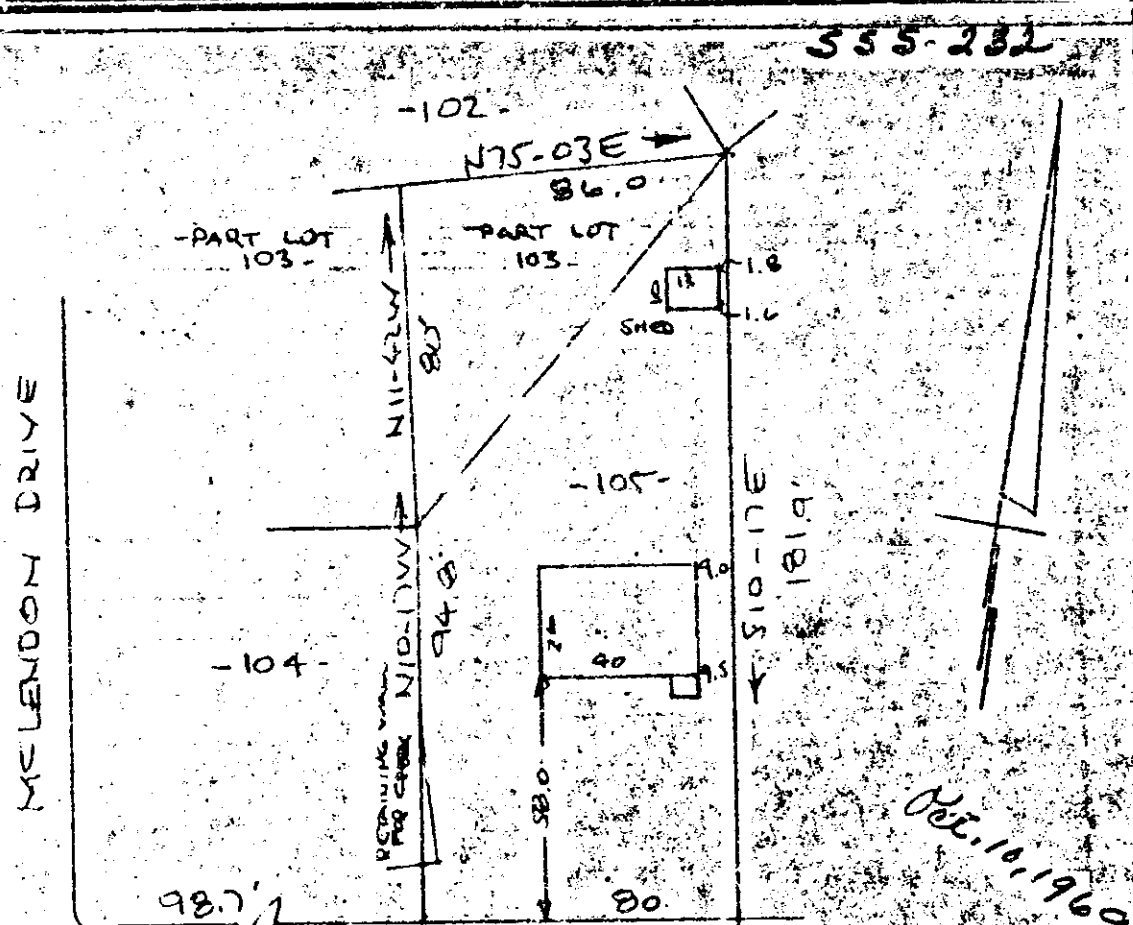

← STA - 43W  
 241-1-223  
 FLORIDA AVENUE  
 WATER & SEWER IN ST. RIM  
 PROPERTY OF  
 CHARLES HENDERSON & JOYCE D. HENDERSON  
 NEAR GREENVILLE, S.C.  
 SCALE: 1" = 40' 14 OCT 1969

This is to certify that on the 4th day of October 1969, I surveyed the property shown on this plat, being known as lot 103 and part of lot 103 on a plat of OAKCREST and recorded in the LMC Office Greenville County, S.C. in Plat Book "63" at Page 110 & 111; and that the property lines, walls and buildings are as shown hereon, and that the walls and buildings located on said lot do not encroach or project on adjacent street or property, and that no adjacent walls or buildings encroach or project on said premises, and no power lines cross this property except as shown hereon.

*R. B. Bruce*  
 R. B. Bruce, R.L.S. #1952

100  
 Picture # SSS-232

CAROLINA ENGINEERING & SURVEYING CO.  
 Greenville, South Carolina

Recorded Oct. 10, 1969 at 9:30 A. M., #8624