


SSS-342

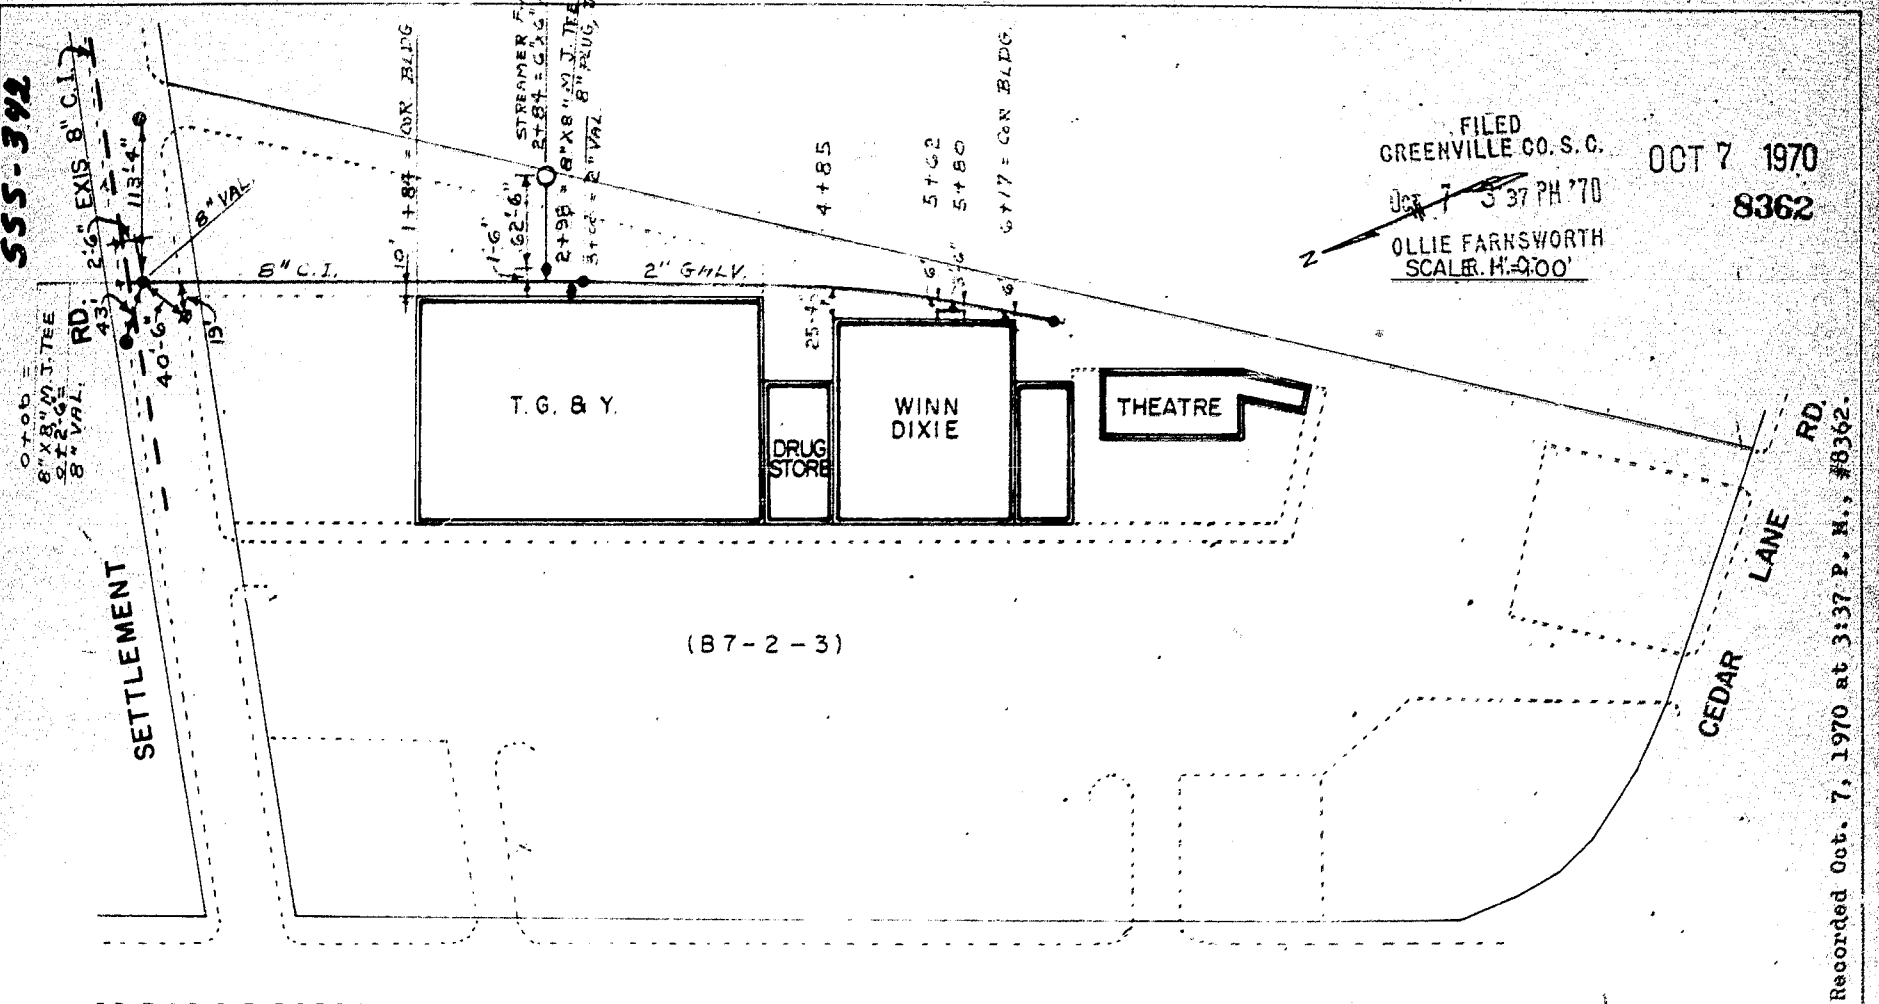

FILED
GREENVILLE CO. S. C.
OCT 7 3 37 PM '70
OLLIE FARNSWORTH
SCAL. 1/4" = 100'

OCT 7 1970
8362

O.T.O.B.
6" X 8" M.J. TEE
8" VAL.

RD.
43
2+6 EXIS 8" C.I.

10' 1+84 = CON. BLDG.

1-6"
1-62-6"
2+98 = 8" X 8" M.J. TEE
3+02 = 2" VAL. 8" PLUG. 2" P

4+85

5+62

5+80

6+17 = CON. BLDG.

T.G. & Y.

DRUG STORE

WINN DIXIE

THEATRE

(B7-2-3)

WHITE

HORSE

RD.

CEDAR LANE RD.

TOWN N COUNTRY REALTY PROP.
SEPTEMBER, 1970

N/C city 111-342

Recorded Oct. 7, 1970 at 3:37 P. M., #8362.

And Deed
598-VII