


551-619

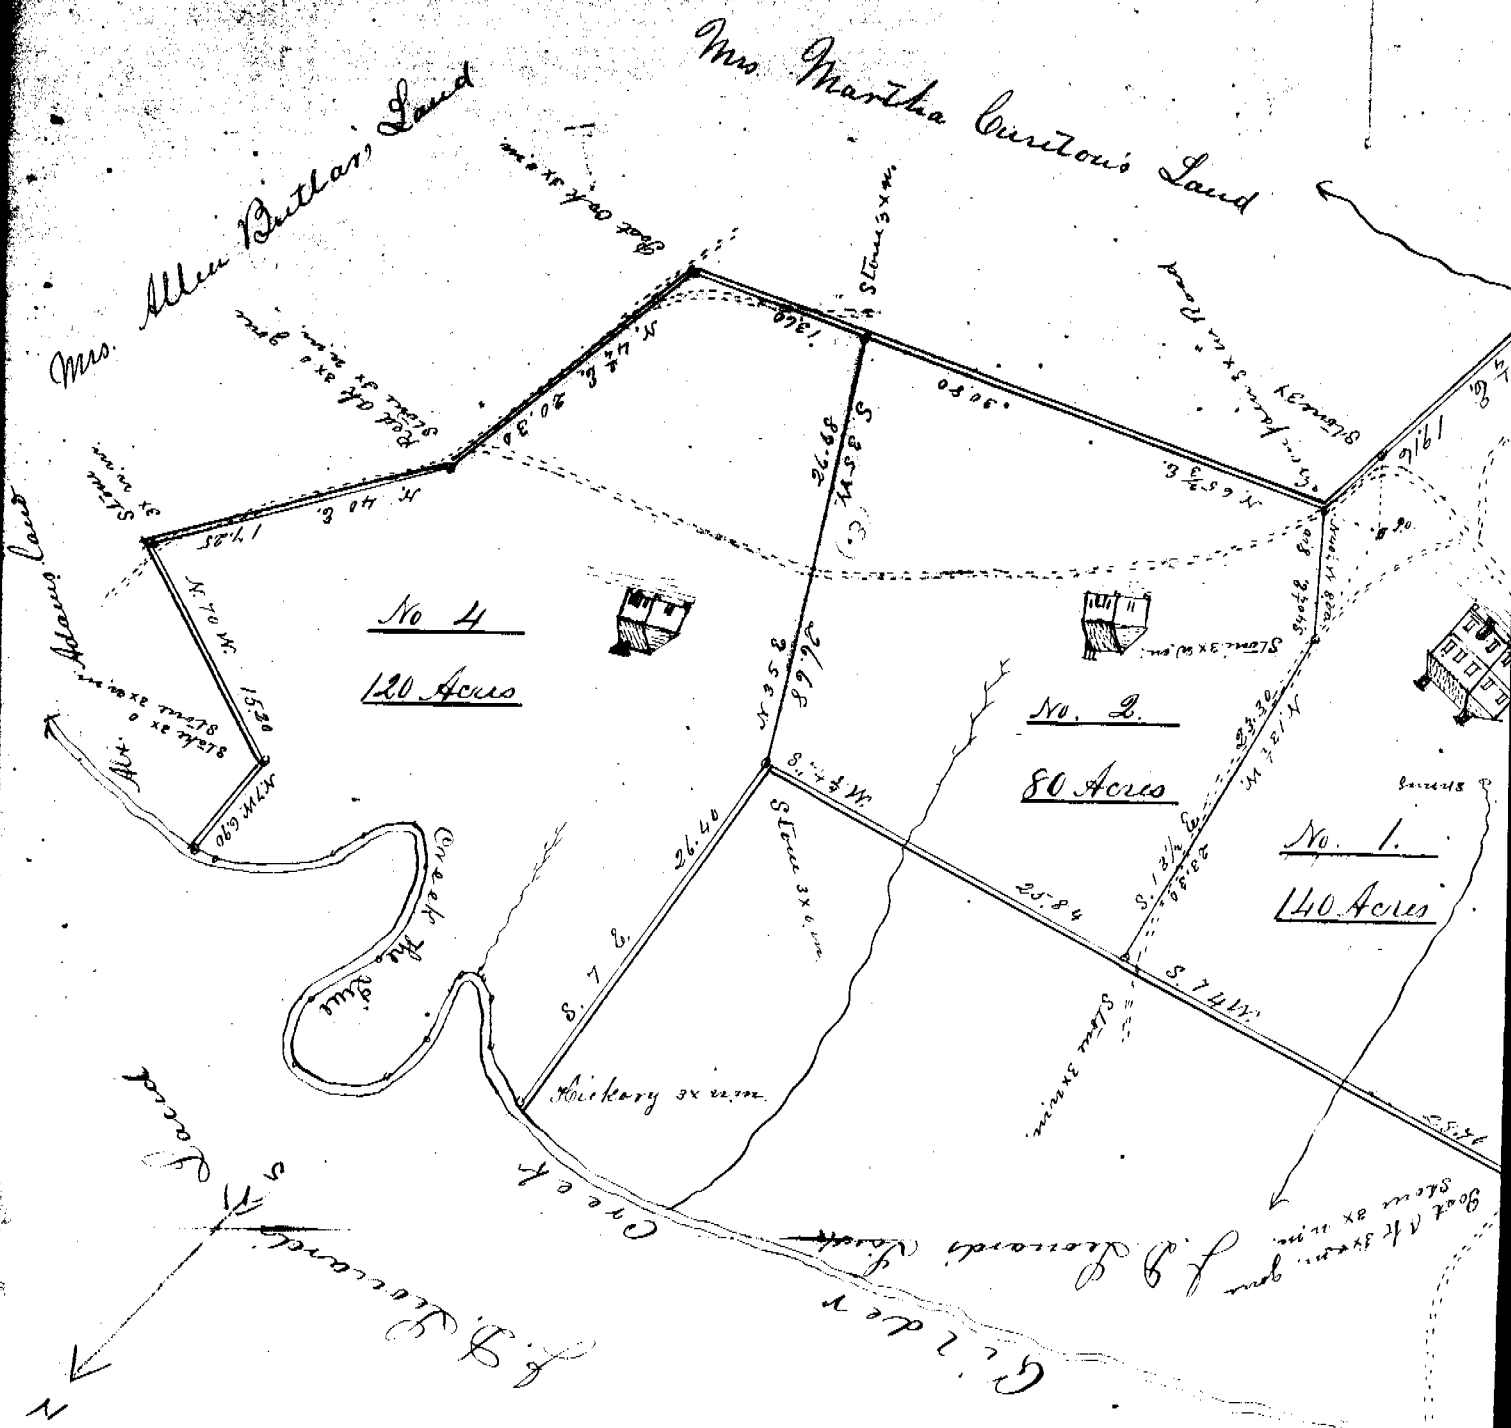

The State of South Carolina
 County of Greenville } Pursuant to an Order of
 Court of Land containing Five Hundred and thirty (530) Acres in
 and Cray Branch Waters of Canoe River, belonging to the
 lands of Dr. Thos. C. Austin, deceased. I have also divided the
 for Sale, as well appear from the above plat.
 Resurveyed and divided the 23rd day of October 1890.