

# Plat Book-TTT-Page 35B

WIDE HAMPTON GARDENS


FORESTER  
PLAT

I CERTIFY THAT THIS SURVEY WAS  
PREPARED BY ME OR UNDER MY  
SUPERVISION AND THAT I AM A  
REGISTERED PROFESSIONAL ENGINEER  
IN THE STATE OF SOUTH CAROLINA  
REG. ENGR. NO. 982

KASSUBA SURVEY FOR  
GREENVILLE APARTMENTS  
FILED IN GREENVILLE, S.C.  
SCALE 1" = 40'  
SEPT. 27, 1968  
M. PIEDMONT ENGINEERS & ARCHITECTS  
GREENVILLE, S.C.

## LEGEND

- SAN SEWER & M.H.
- WATER LINE
- FENCE
- LIGHT POLE
- UNDERGROUND TEL. E. BOX
- UNDERGROUND POWER E. BOX
- CATCH BASIN
- CONC. WALK
- CONC. CURB
- CONC. PAD
- WATER METER
- SUNDECKS

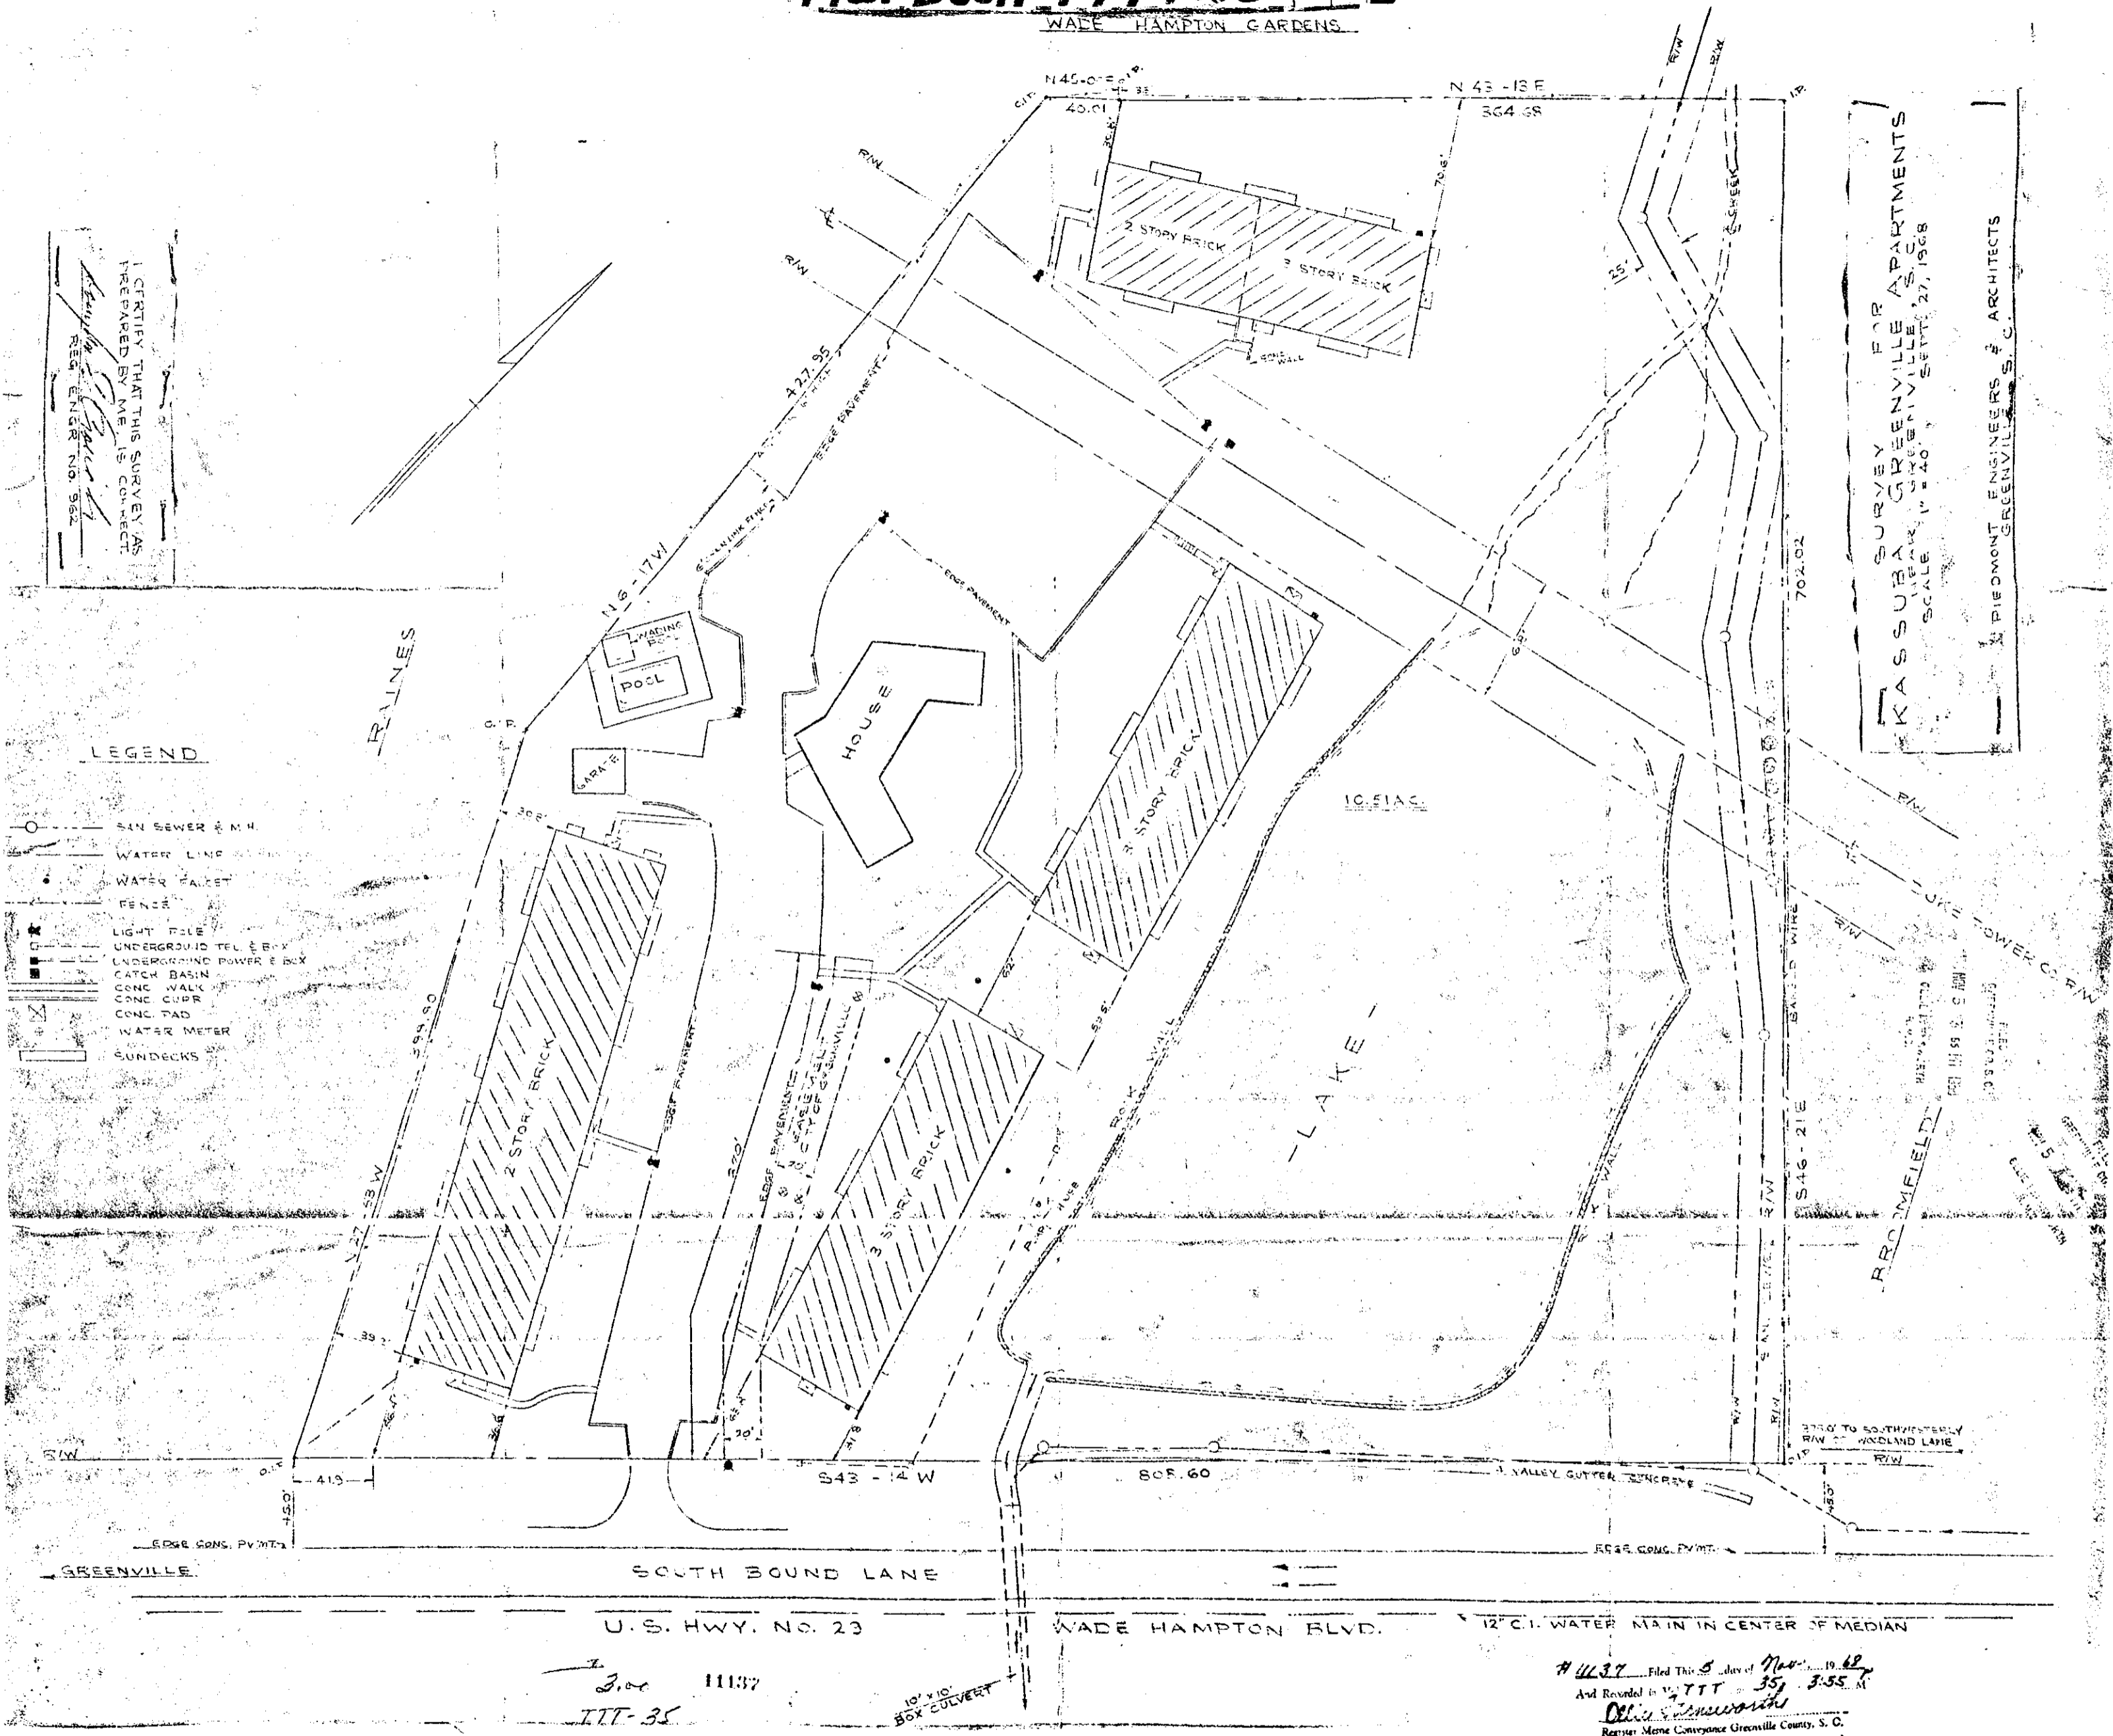

11137  
ITT-35

# 4437 Filed This 5 day of Nov. 19 68  
And Recorded in TTT 35, 355 M  

