


113748 Filed This 14 day of Aug 1970
 And Recorded in Vol. U.U. Page 191 at 3:52 P.M.
 Ollie Farnsworth
 Register Mesne Conveyance Greenville County, S. C.

Plat Book-UUU-Page 191A

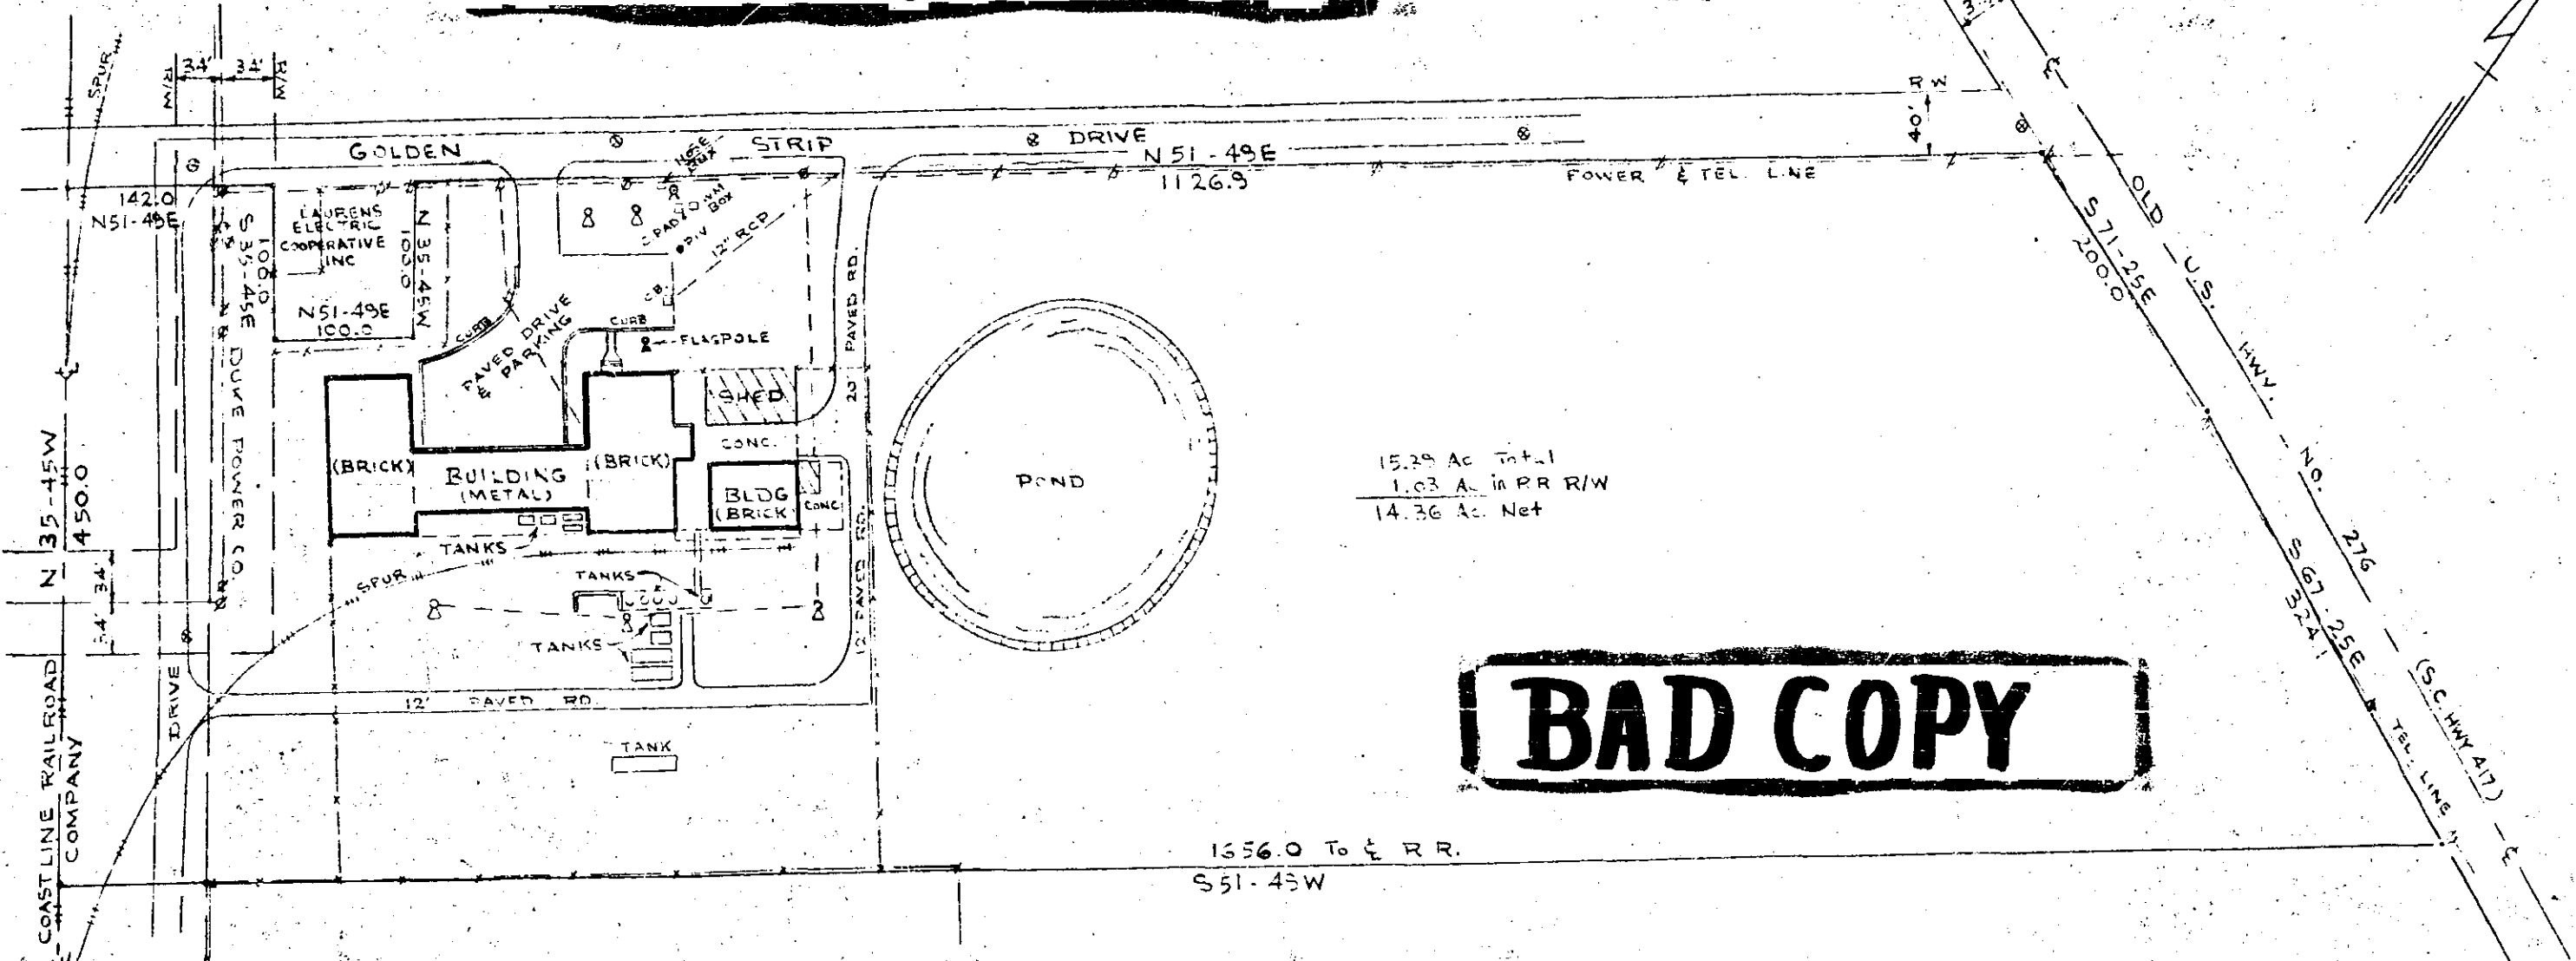

15.29 Ac. Total
 1.03 A. in RR R/W
 14.36 Ac. Net

BAD COPY

FILED
 GREENVILLE-CO. S. C.
 AUG 14 3 52 PM '70
 OLLIE FARNSWORTH
 R.M.C.


MA.1-1-16.2

This is to certify that on the 13th day of Mar., 1970, I surveyed the property shown on this plat, and that the property lines, walls and buildings are as shown hereon that the buildings located on said lot do not encroach or project on adjacent streets or property and that no adjacent walls or buildings encroach or project on this lot; and that there are no utility lines crossing this property except as shown.

- LEGEND**
- ⊗ FIRE HYDRANT
 - ⊙ LIGHT POLE
 - ⊕ MANHOLE
 - X — FENCE (6' CHAIN LINK)
 - ⊗ UTILITY POLE

AUG 14 1970
 3718

James D. Cain
 Registered Land Surveyor No. 3320

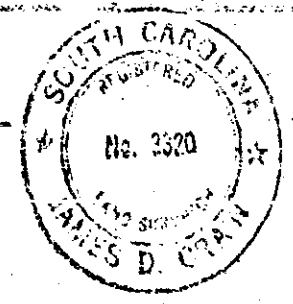

PROPERTY OF
TRYLON CHEMICALS, INC.
 GREENVILLE CO., S. C.
 SCALE 1"=100' MAR 19, 1970

PIEDMONT ENGINEERS & ARCHITECTS
 GREENVILLE, S. C.

UUU-191 #125