Plat Book-VVV-Page 133

#16011 Filed This 6th day of Dec. 19 67
And Recorded in Vol. VVV Page 133 at 4:24 P.M.
Alice Samuelson
Register Mesne Conveyance Greenville County, S. C.

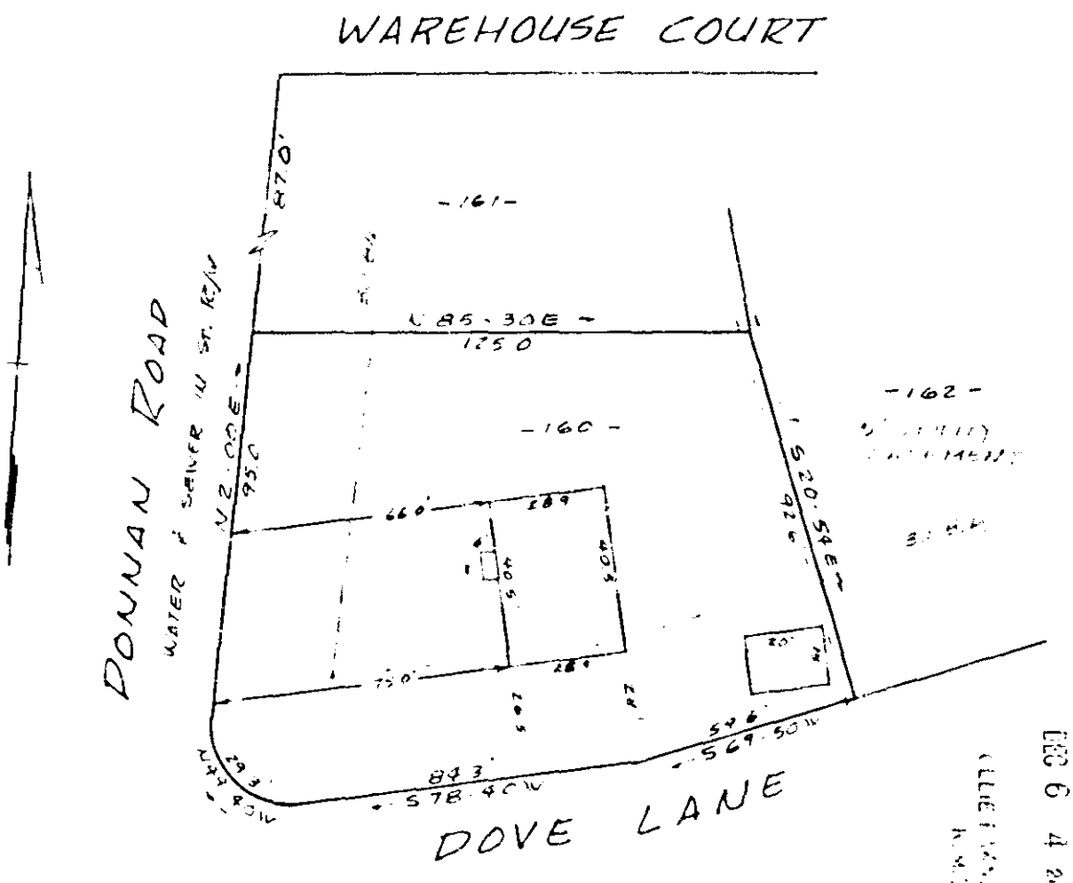

PROPERTY OF
H. BLAIR BRIDLE & ETHER LEA BRIDLE
NEAR GREENVILLE, S.C.
SCALE 1"=40' 6 DEC. 1967

This is to certify that on the 6th day of December 1967, I surveyed the property shown on this plat, being known as lot 160 on plat of SUMMIT HIGHWAY HOME SITES and recorded in the R.M.C. Office Greenville County, S.C. in plat book "F" page 53, and also being known as property of H. BLAIR BRIDLE and ETHER LEA BRIDLE and recorded in the R.M.C. Office in plat book page ; and that the property lines, walls and buildings are as shown hereon, and that the buildings located on said lot do not encroach or project on adjacent street or property, and that no adjacent buildings or walls encroach or project on said premises other than shown on this plat.

R. B. Bruce
R.B. Bruce R.L.S. # 1952.

16011

CAROLINA ENGINEERING AND SURVEYING CO.
GREENVILLE, S.C.

VVV-133

500