


# Plat Book-VVV-Page 165B

#17947 Filed This 29<sup>th</sup> day of Dec. 1967  
 And Recorded in Vol. VVV Page 165 at 2:28 P.M.  
*Oliver*  
 Register Meme Conveyance Greenville County, S. C.

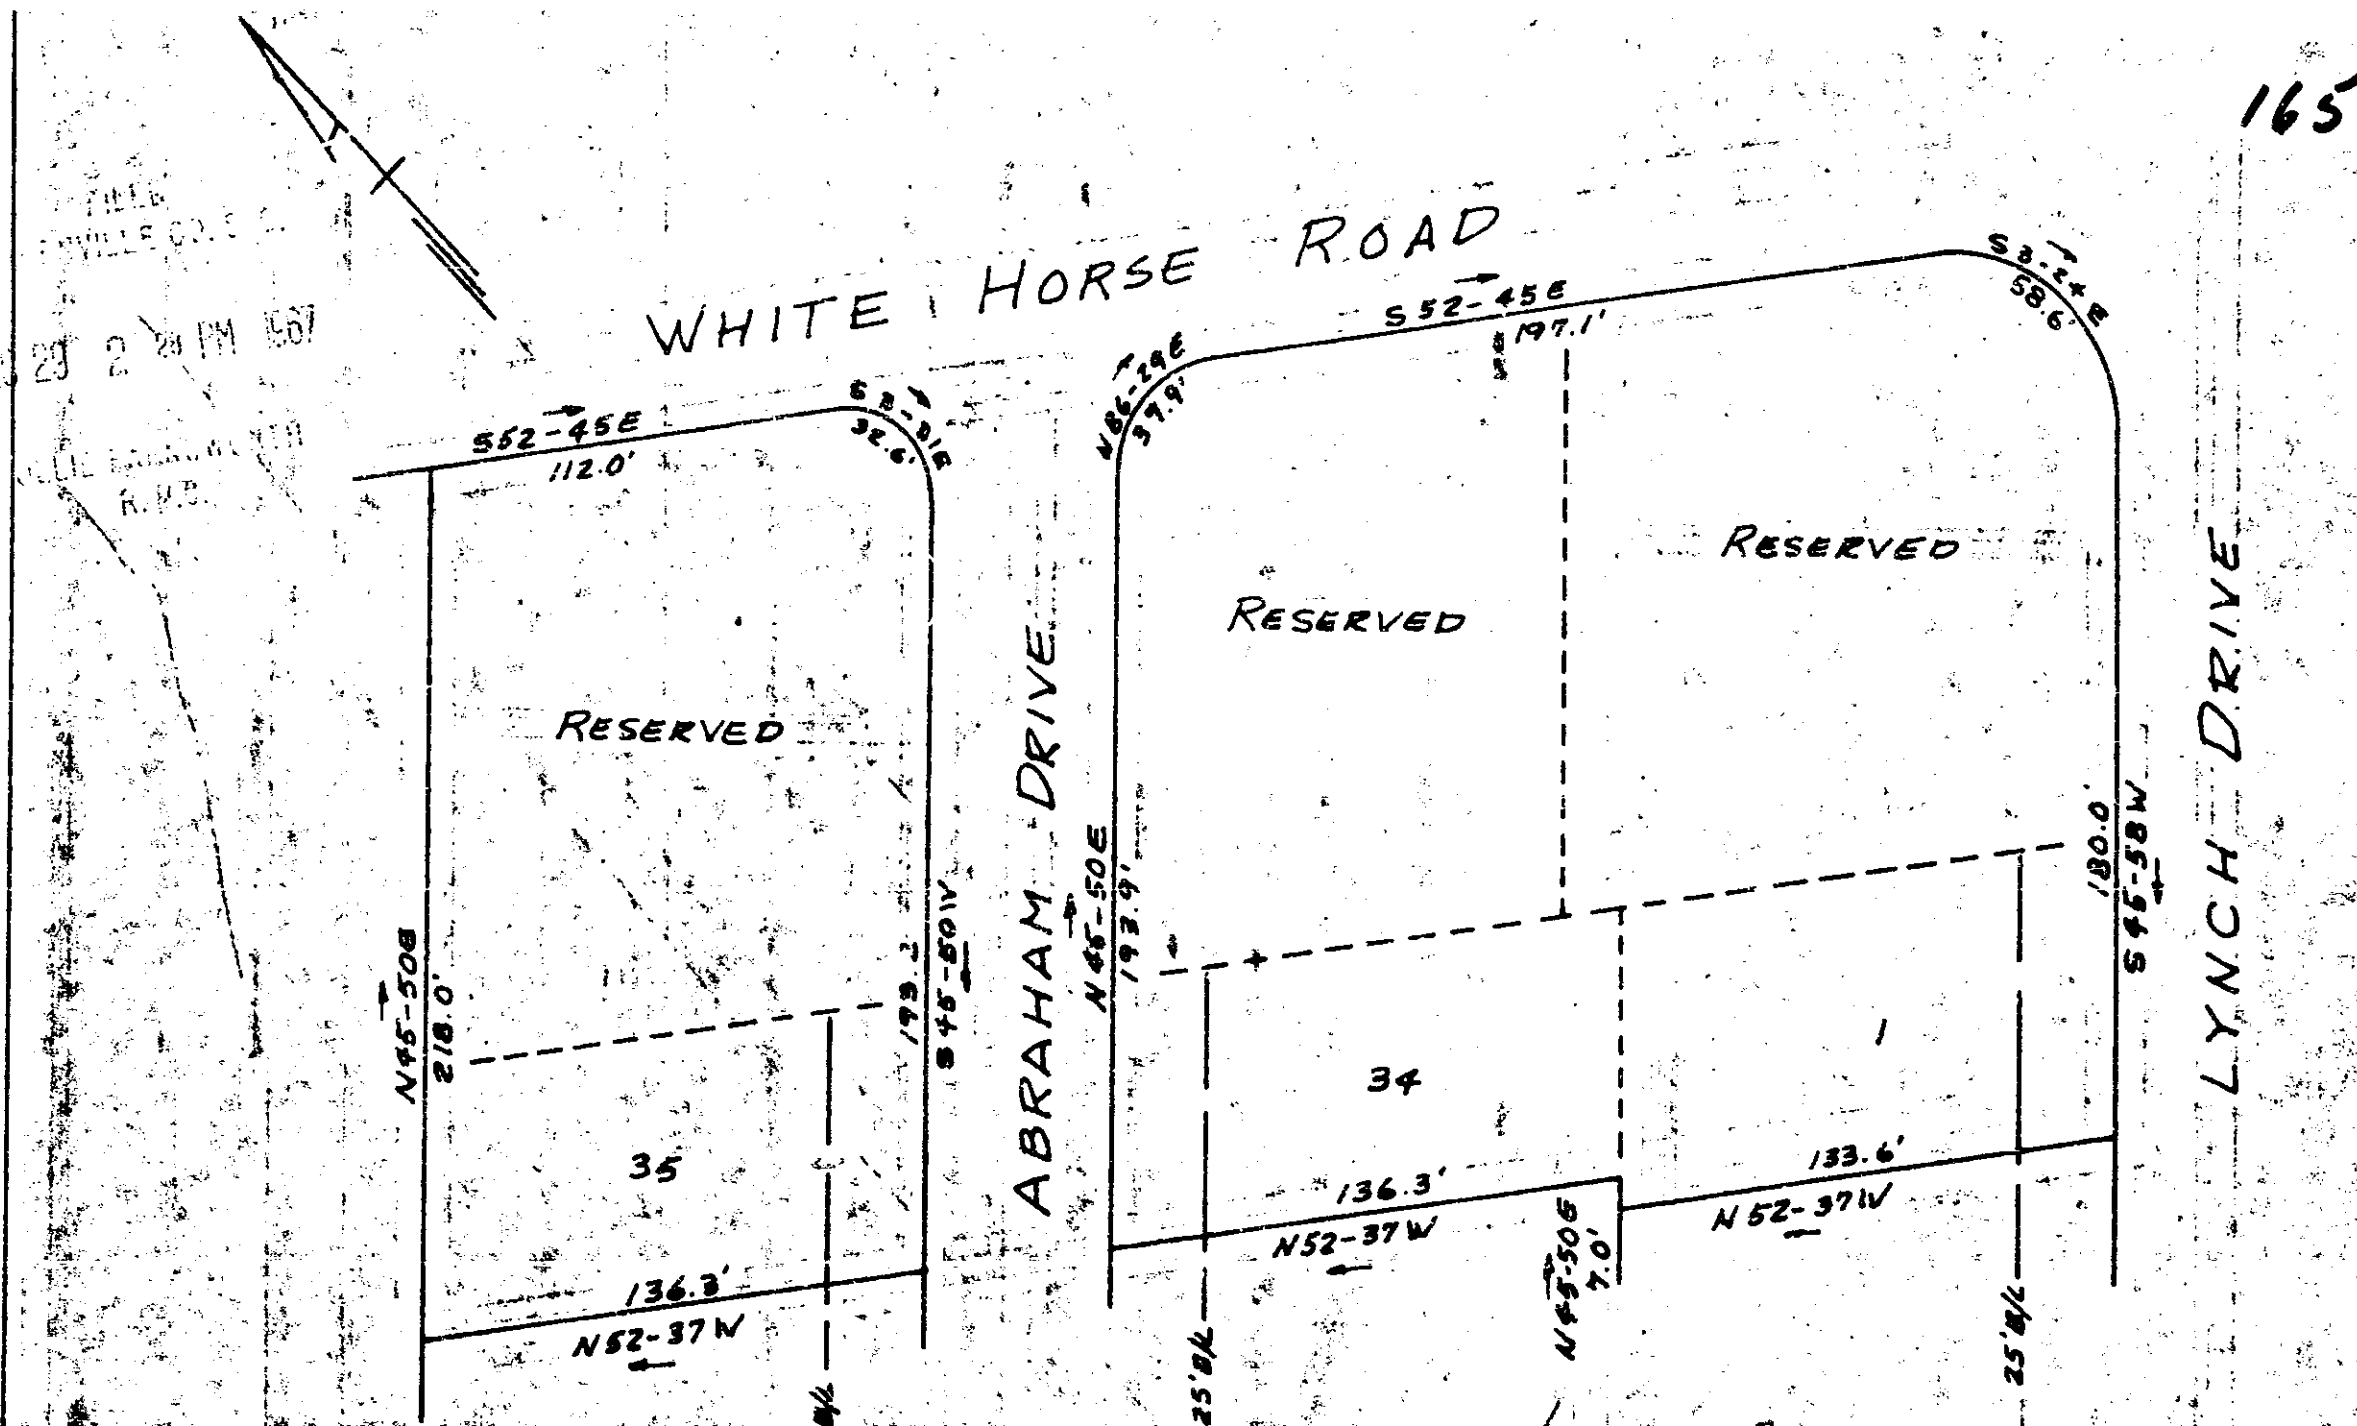

165

ALTERED BULK  
 REVISION OF RESERVED  
 AREAS AND LOTS 1, 34 AND 35

*Lincoln Forest*  
 NEAR GREENVILLE, S. C.  
 SCALE 1" = 60' OCT. 19, 1967  
 CAROLINA ENGINEERING & SURVEYING CO.  
 GREENVILLE, S. C.

17947

VVV-165