PLAT BOOK XXX PAGE 37 A

#22148 Filed This 21 day of Feb 1968
And Recorded in Vol XXX Page 37 at 1:21 M
Alice Ainsworth
Register Mesne Conveyance Greenville County, S. C.

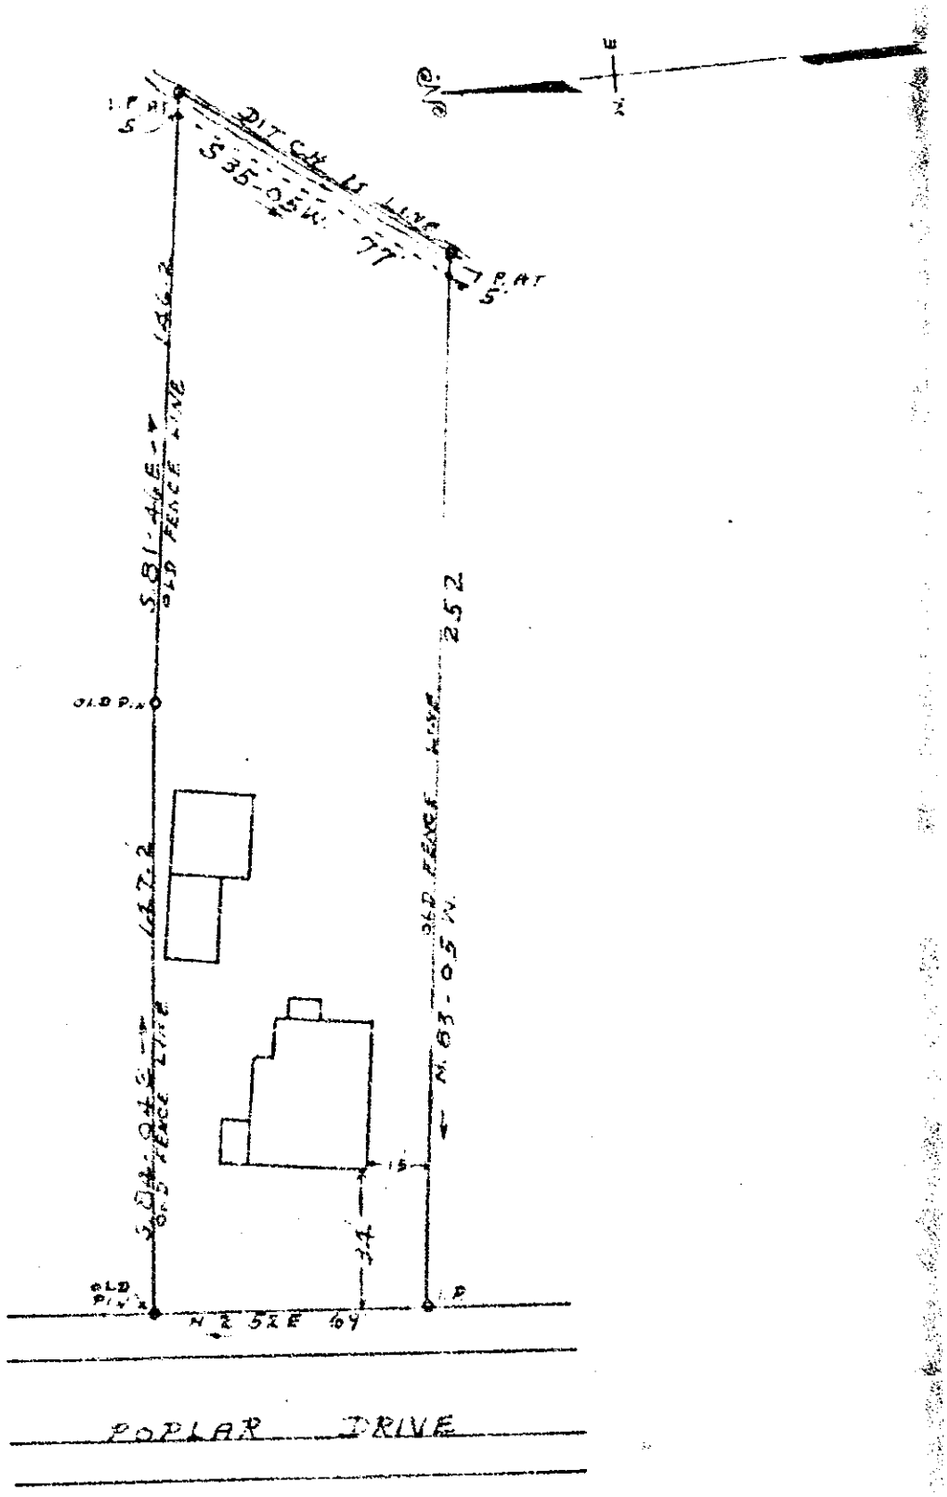

PROPERTY OF

WAYNE · LEE · ROCHESTER

LOCATED AT 605 POPLAR DRIVE IN GREER

CHICK SPRINGS TOWNSHIP GREENVILLE COUNTY

SOUTH CAROLINA

SCALE: 1" = 40 FEET FEB 13 1968

SURVEYED FEB · 13 · 1968

H. S. BROCKMAN REG. SURVEYOR
GREER, S. C. NO. 959

FILED
GREENVILLE CO., S. C.
FEB 21 1 21 PM 1968
ALICE

504 XXX-37

22148 22148

37