
And Recorded in Vol. 4 4 4 Page 19 at 3:56 M.

Register Morne Conveyance Greenville County, S. C.

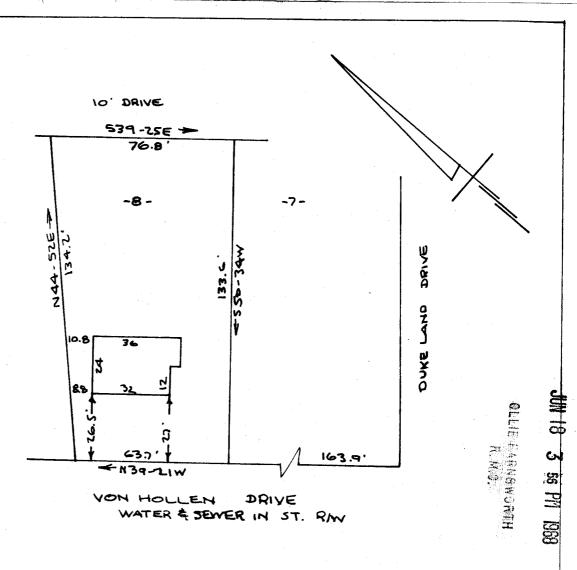

PROPERTY OF

JAMES R. TAYLOR

NEAR GREENVILLE, S.C.

SCALE 1= 40' 17 JUNE 1968

This is to certify that on the 12th day of June 1968, I surveyed the property shown on this plat, being known as Lot 8 on a plat, being known as the property of ETHEL Y. PERRY and recorded in the R.M.C. Office Greenville County, S.C., in Plat Book "BB", Page 39; and also known as the property of JAMES R. TAYLOR and recorded in the R.M.C. Office Greenville County, S.C., IN Plat Book YYY Page 19; and that the property lines walls and buildings are as shown hereon; and that the walls and buildings located on said lot do not encreash or project on adjacent street or property, and that the adjacent buildings or walls do not encreach or project on said premises, and no power lines cross this property except as shown hereon.

R.B. BRUCE RLS #19

32608

yyy-19 50 d