Plat Book-YYY-Page 27 B

#33394 Filed This 27 day of June 1968
And Recorded in Vol. YYY Page 27 at 3:18 P.M.
Ollie Farnsworth
Register Mesne Conveyance Greenville County, S. C.

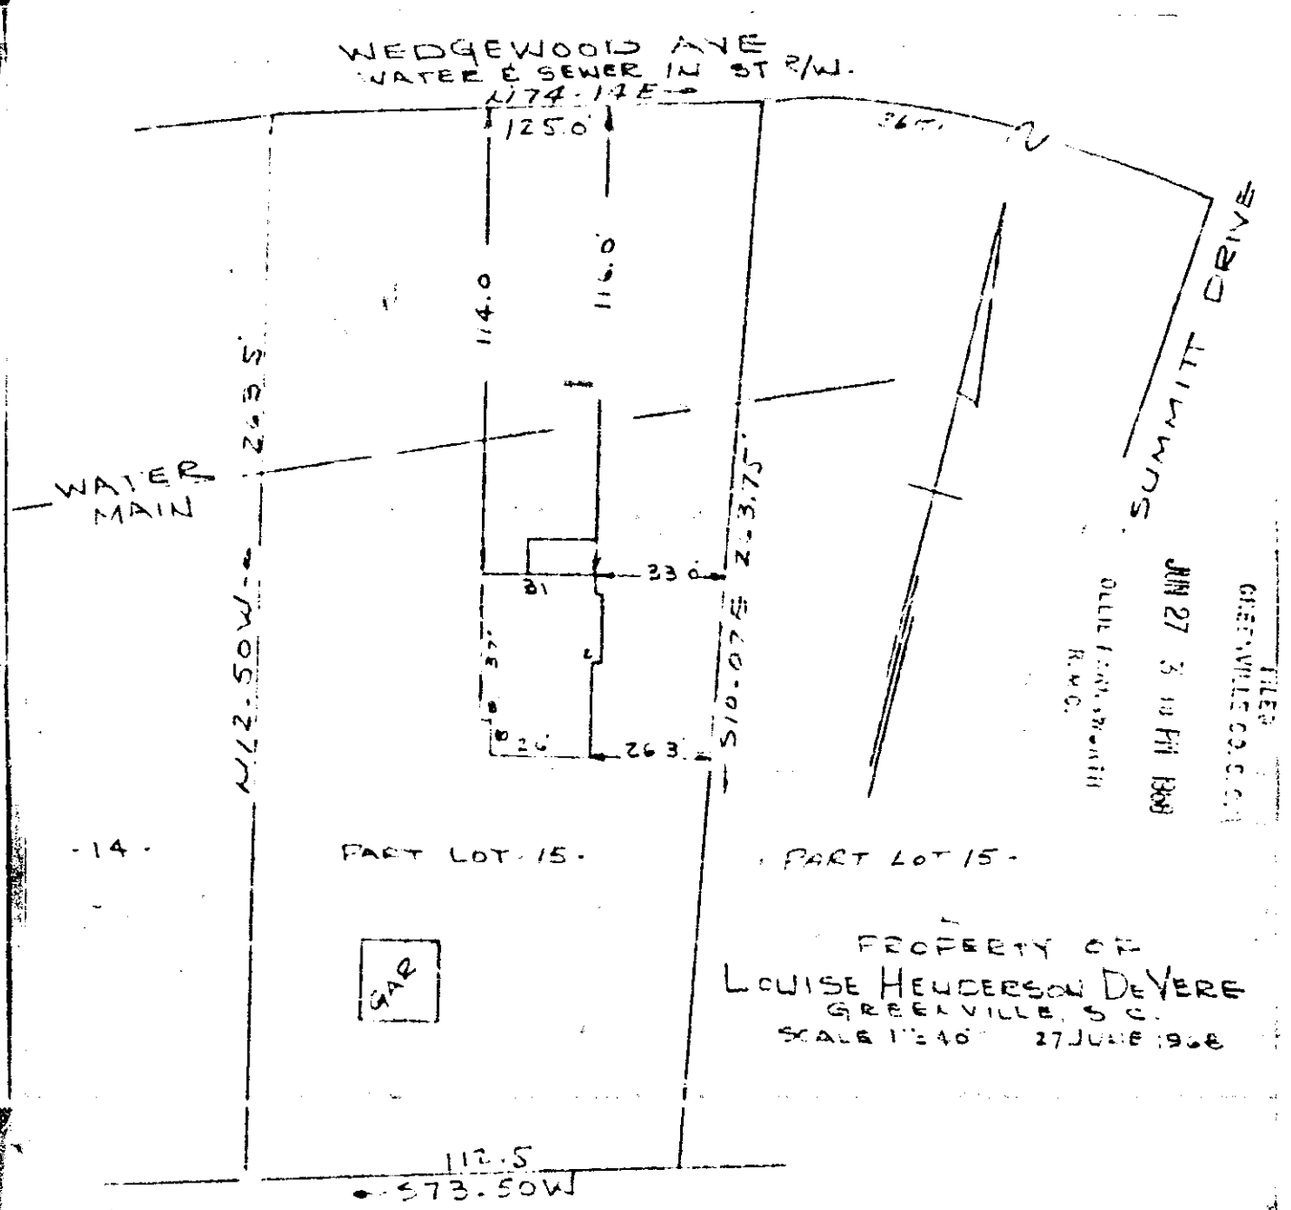

I certify that on the 27th day of June 1968, I surveyed the property shown on this plat being known as Part of Lot 15 on a Plat of WEST CROFTSTONE ACRES and recorded in Plat Book "E" Page 36 and also known as property of LOUISE HENDERSON DeVERE AND RECORDED in the R.M.C. Office Greenville County, S.C. in Plat Book Page ; and that the property lines, walls and buildings are as shown hereon, and that the walls and buildings located on said lot do not encroach or project on adjacent street or property, and that no adjacent buildings or walls encroach or project on said premises, and no power lines cross this property except as shown hereon.

50¢ JUN 27 1968

R.B. Bruce
R.B. BRUCE RLS #1952

YYY-27

33394

CAROLINA ENGINEERING AND SURVEYING COMPANY
GREENVILLE, SOUTH CAROLINA

27