


# Plat Book-YYY-Page 79A

#1844 Filed This 22 day of July 1968  
 And Recorded in Vol. 114 of Page 177 at 12:12 P.  
*Ollie Evansworth*  
 Register Meane Conynatus Greenville County, S. C.

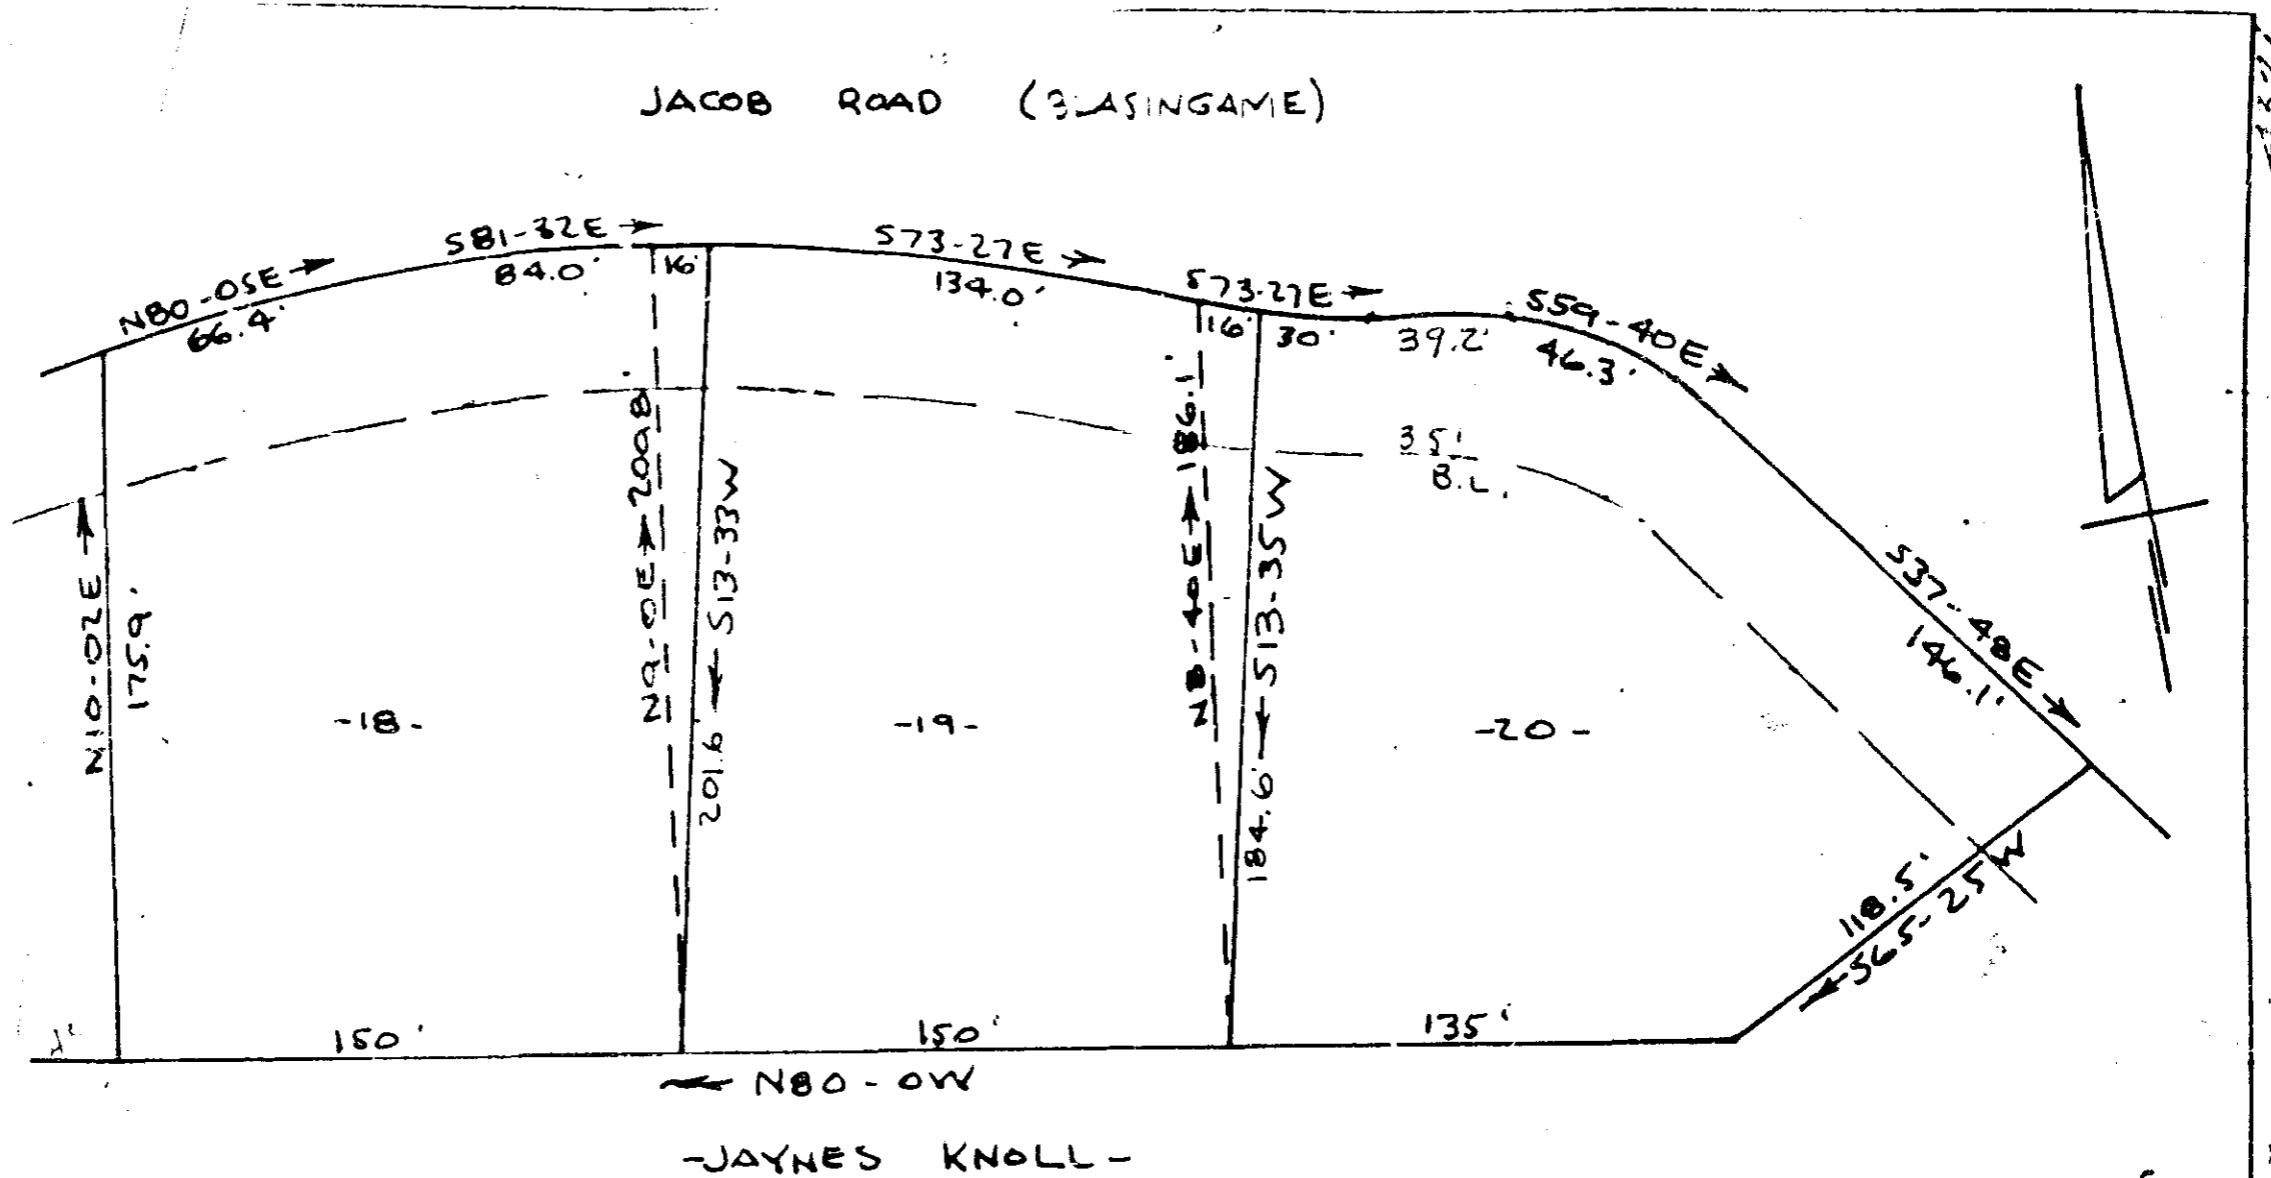

REVISION OF LOTS 18, 19, & 20  
**JAYNES KNOLL**  
 NEAR GREENVILLE, S. C.  
 SCALE 1"=60' 3 JUNE 1968

OLLIE EVANS WORTH  
 R.M.S.

JUL 22 12 12 PM 1968

1811

CAROLINA ENGINEERING & SURVEYING CO. 322 504.  
 GREENVILLE, S.C. YYY-79

4320