


#2910 Filed This 2nd day of Aug. 1968
 And Recorded in Vol. 444 Page 95 at 8:50 A.M.
 Ollie Farnsworth
 Register Mesne Conveyances Greenville County, S. C.

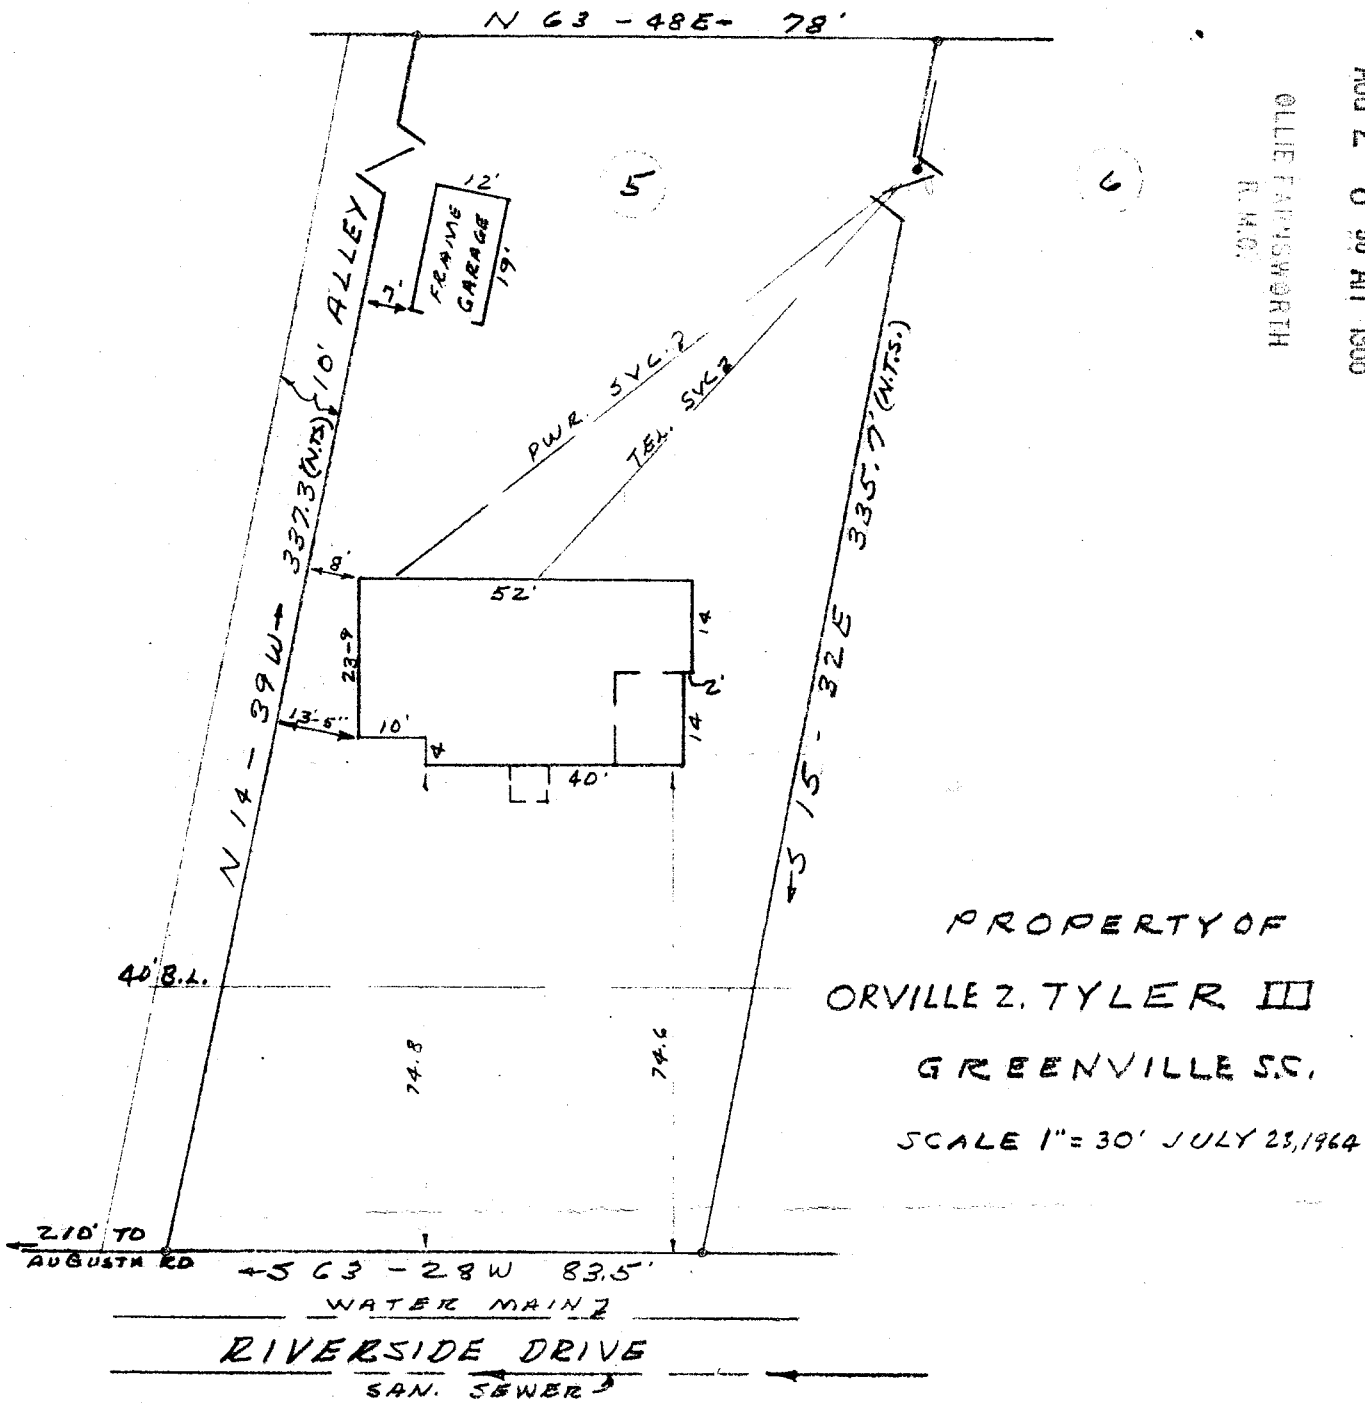

FILED
 GREENVILLE CO. S.C.
 AUG 2 8 50 AM 1968
 OLLIE FARNSWORTH
 R.M.C.

PROPERTY OF
 ORVILLE Z. TYLER III
 GREENVILLE SC.
 SCALE 1" = 30' JULY 23, 1964

This is to certify that on July 23, 1964, I surveyed the property shown on this plat, known as Lot No. 5 on plat of property of Ables and Razor, filed in the R.M.C. Office for Greenville Co. in Plat Book E at page 153, and that the property lines, walls and building are as shown hereon; that the building located on said lot does not encroach or project on adjacent streets or property, and that no adjacent walls or buildings encroach or project on said premises, and that no utility lines cross this property except as shown hereon.

Surveyed by H. C. [Signature] 2910
 S.C. Reg. No. 2509 444/95
 YYY-95

property transferred to Linard