
LIST DOOK-1111-L93E TOAN

And Recorded in Vol 44 41 oge 10 fg. 10:02 k.

Register Many Conceptable County, S. C.

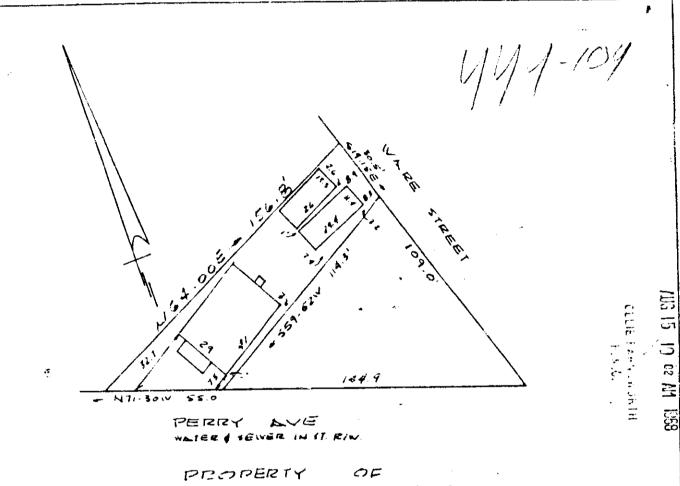

PROPERTY OF

LEROY CHAPPELL & IZOLA D. CHAPPELL

GREENVILLE S. C.

SCALE 1"-40" 7 AUG 68

This is to certify that on the 7th day of August 1968 I surveyed the property shown on this plat being known as the property of CHARLES L. AIDGEWAY and recorded in the RMC Office oreenville County 5.C., in Deed Book 302 at Page 257, and also known as the property of LEROY CHAPPELL & IZOLA D. CHAPPELL and recorded in the RMC Office oreenville County 5.C. in Plat Book "774" Page/Cl and that the property lines, walls and buildings are as shown hereon, and that the walls and buildings located on said lot do not encroach or project on adjacent street or property, and that no adjacent buildings or walls encroach or project on said premises, and no power lines cross this property except as shown hereon.

447-1-1

R.b. BRUCE RLS #1952

CAROLINA ENGINEERING & SURVEYING COMPANY Greenville, South Carolina