


#4264 Filed This 22 day of Aug. 1968  
 And Recorded in Vol. 444 Page 121 at 2:19 P.  
 Cecil J. [Signature]  

Note: I surveyed the property shown on this plat on August 10, 1968, as described in R. E. Mort. Book 1001, Page 149 and being known as lot 14 of Golden Strip Subdivision of P. W. Wenck, by L. C. Godsey, dated 2/9/56, and recorded in Plat Book TF, Page 19, in the R.M.C. Office for Greenville County, and that all property lines, walls and buildings are shown thereon, that the buildings located on said lot do not encroach or project on adjacent streets or property, and that no adjacent buildings or walls encroach or project on said premises.

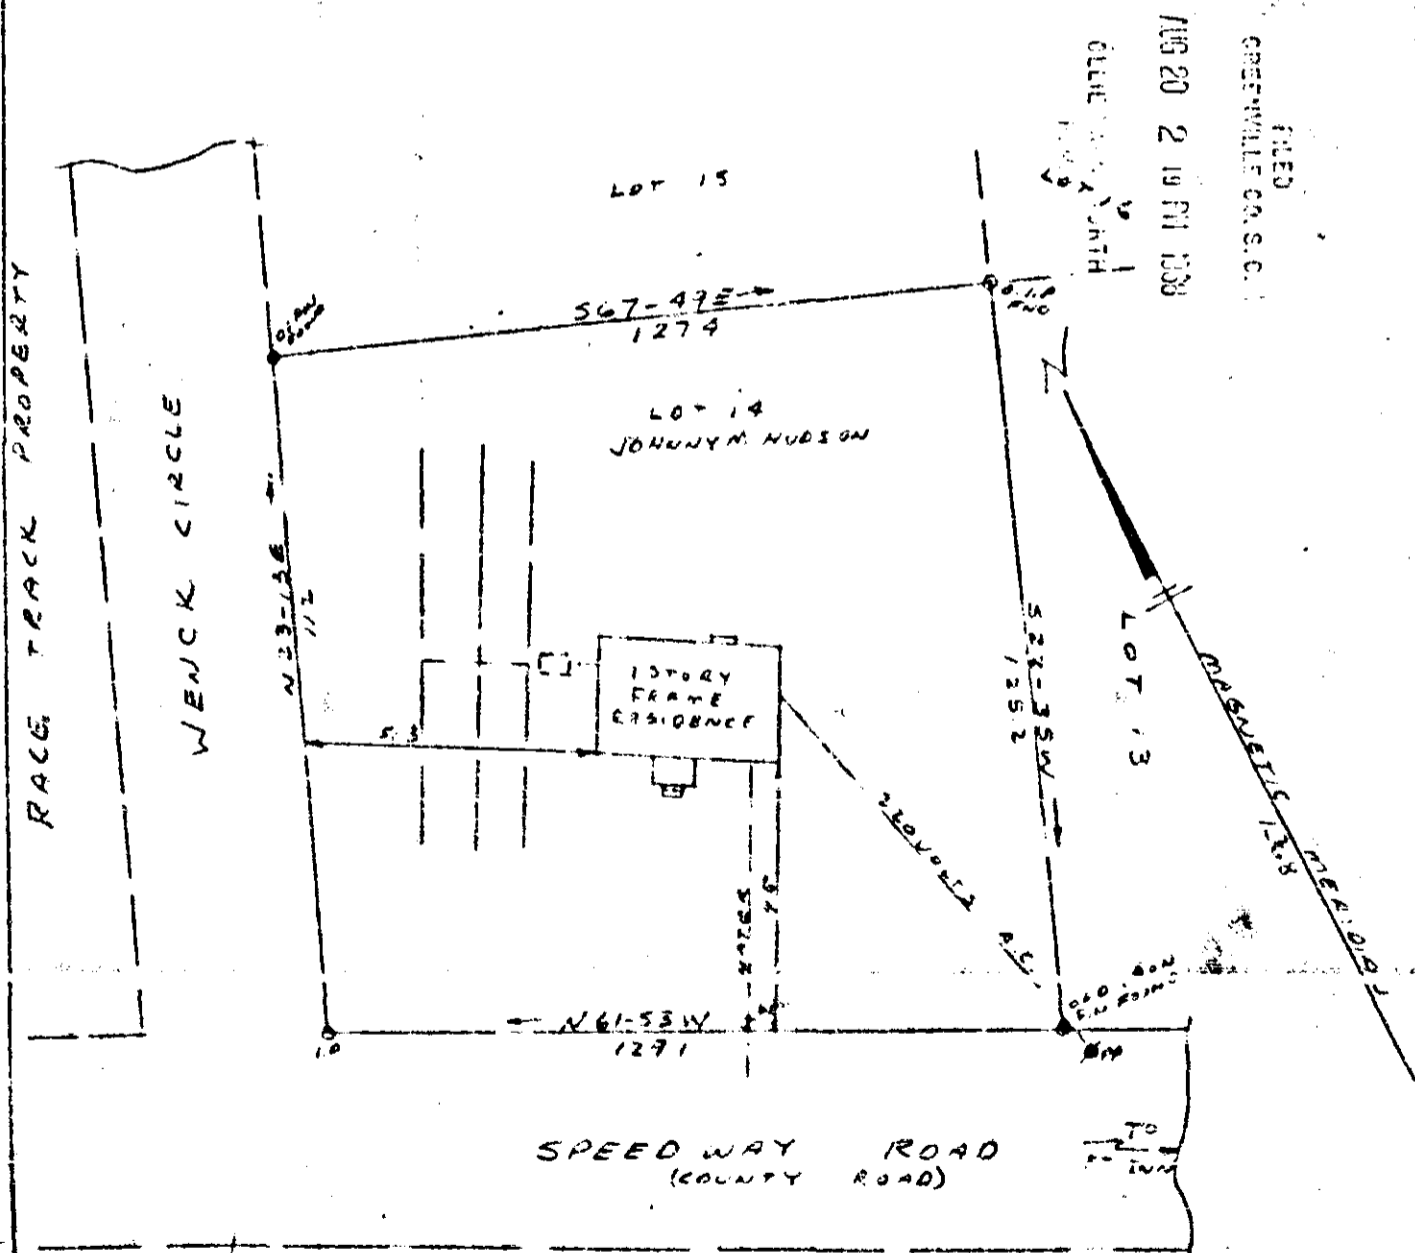

FILED  
 GREENVILLE CO. S. C.  
 AUG 20 2 19 PM 1968

1201  
 YYY-121

PLAT OF PROPERTY OF  
 JOHNNY M. HUDSON

LOCATED IN CITY OF FOUNTAIN INN, ON SPEEDWAY ROAD, IN  
 FAIRVIEW TOWNSHIP, GREENVILLE COUNTY, SOUTH CAROLINA  
 SCALE: 1" = 30'  
 8-10-68 R.M. [Signature] S. #1836