
17-13 DOOK-1111-1398 T 7-12-14

And Recorded in Vol. 4 4 Page 125 . 2:53 . 2.

Register Moore Compage we Commodic Country, S. C.

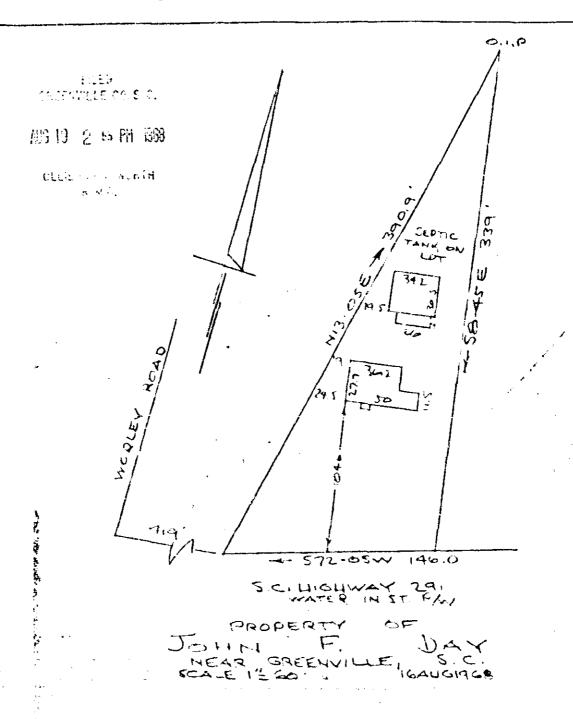

This is to certify that on the 16th Day of August 1968 I surveyed the property shown on this plat being known as the Property of JOHN F. DAY and recorded in the RMC Office Greenville County, S.C., in Deed Book 752 at Page 175 and also recorded in the RMC Office Greenville County, S.C. in Plat Book " at Page ; and that the property lines, walls and buildings are as shown hereon, and that the walls and buildings located on said let do not encroach or project on adjacent street or property, and that no adjacent buildings or walls encroach or project on said premises, and no power lines cross this property except as shown hereon.

4209

R.B. Bellie MS #1952

CAROLINA ENGINEERING AND SURVEYING COMPANY Greenville, South Carolina

42-22