


# 8014 Filed This 1 day of Oct. 1967  
 And Recorded in Vol. 444 Page 195 at 2:24 P.  
 Ollie Strang

Register Mesne Conveyance Greenville County, S. C.

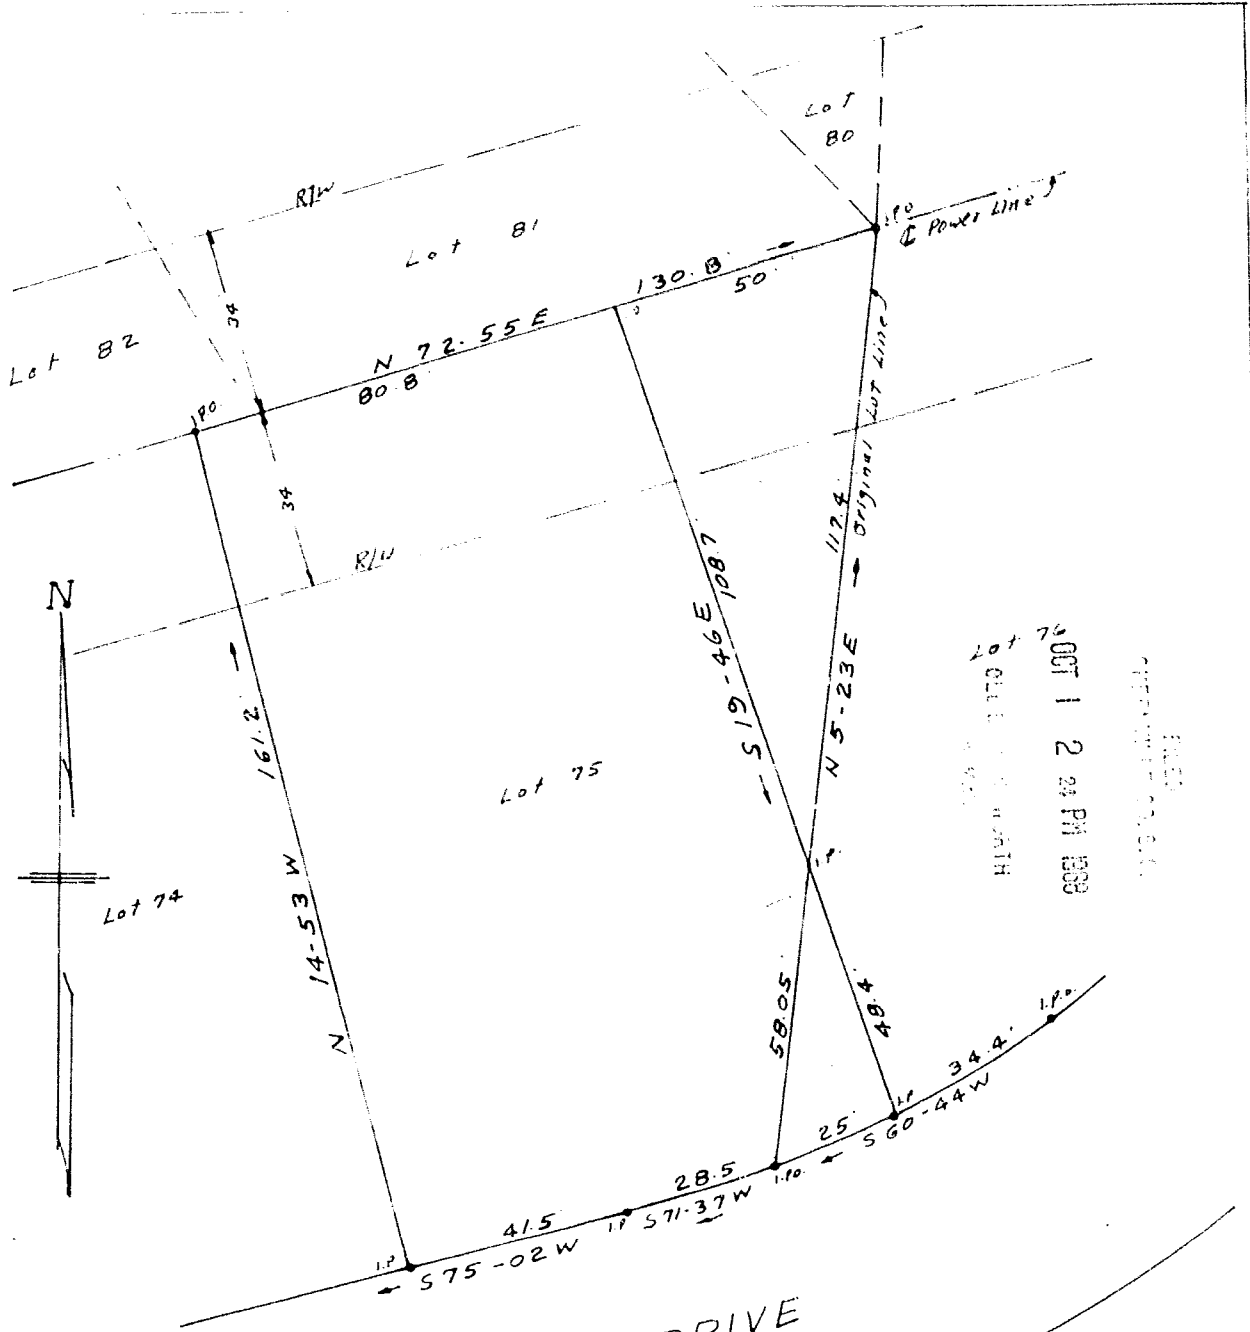

FILED  
 OCT 1 2 24 PM 1967  
 CLERK OF COURTS  
 GREENVILLE, S. C.

8014

50±

444-195

Revision - lots 75 + 76  
 Plat # 2 - Thornwood Acres

Ref: Plat No 2 Thornwood  
 Acres recorded in plat  
 Book MM page 195  
 Greenville Co. Office

PROPERTY OF  
 THOMAS R. STRANGE

GERALD F. & JUDY ANN H. MOORE

24.4 Jay Cas

NEAR GREENVILLE S. C.

SCALE 1" = 30'

DEC 1967

195

