PLAT BOOK III Page

#8276 Filed This 3 day of Oct. 1968
And Recorded in Vol. 944 Page 199 at 10:24 AM
Ollie Farnsworth
Register Mesne Conveyance Greenville County, S. C.

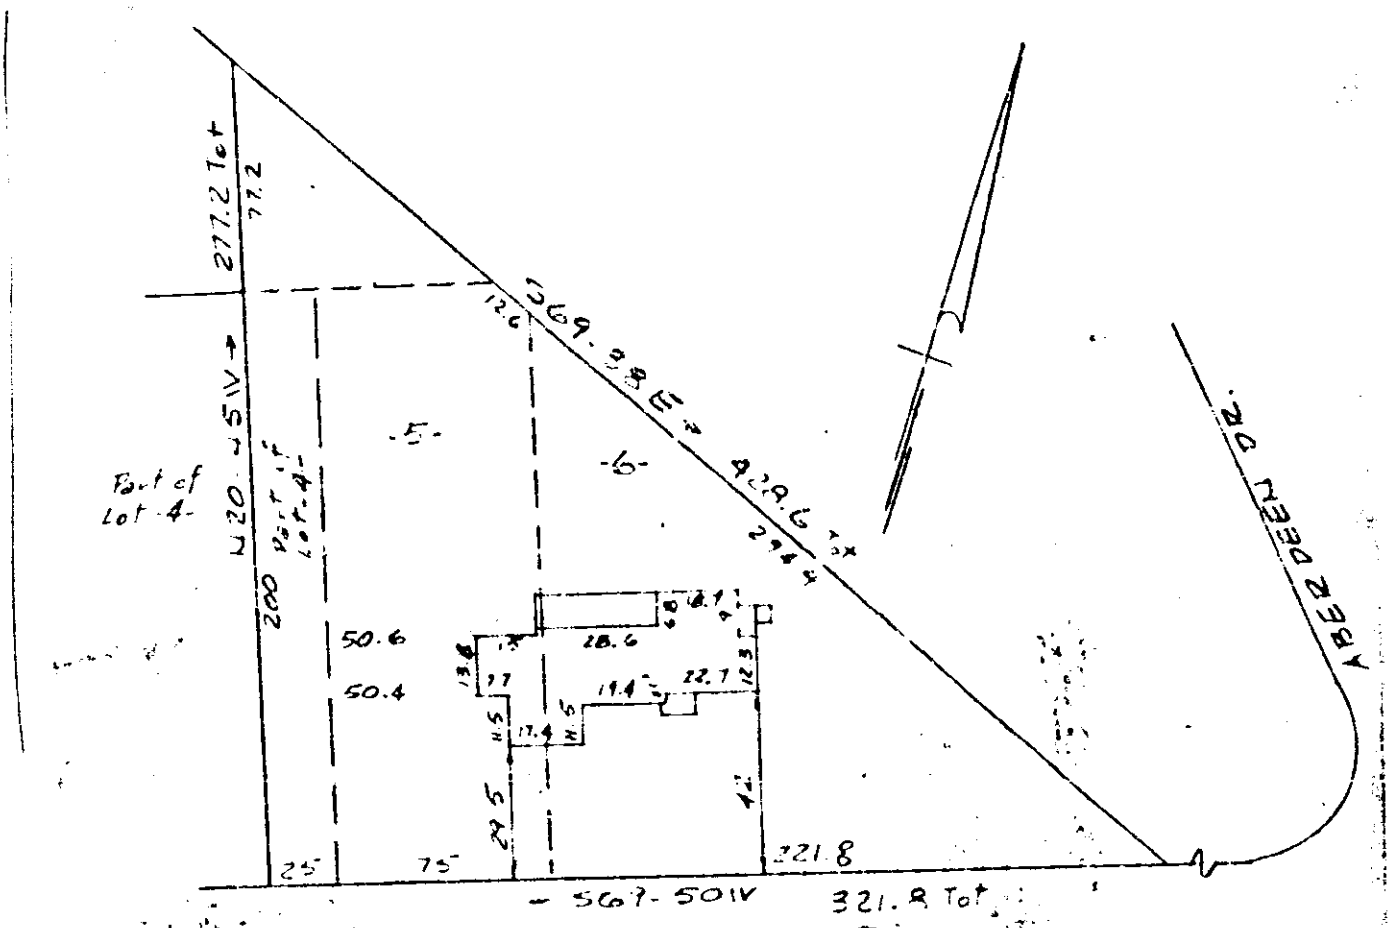

This is to certify that on the 30th Day of September 1968 I surveyed the property shown on this plat being know as Lots 5 & 6 and a Portion of Lot 4 and a portion of an unnumbered lot, on a plat of the property of J.B. League and recorded in the RMC Office Greenville County, S.C., in Plat Book "I" at Page 53 and also known as the property of LEROY & GOLDIE B. LIPSEY and recorded in the RMC Office Greenville County S.C., in Plat Book WWW at Page 199; and that the property lines, walls and buildings are as shown hereon and that the walls and buildings located on said lot do not encroach or project on adjacent street or property, and that no adjacent buildings or walls encroach or project on said premises, and no power lines cross this property except as shown hereon.

THIS PLAT IS NOT A SUBDIVISION AS DEFINED BY THE GREENVILLE COUNTY SUBDIVISION REGULATIONS.

10/3/68
Chairman, Secretary, or Director of Planning.
Greenville County Planning Commission

R.B. Bruce
R.B. BRUCE RLS #1952

8276

CAROLINA ENGINEERING AND SURVEYING COMPANY
Greenville, South Carolina

10:24 A.M.
OCT 3 - 1968
4574

44-9/11