Plat Book-ZZZ-Page 13A

#9152 Filed This 14 day of Oct. 19 68
And Recorded in Vol. ZZZ Page 13 at 12:31 P.M.
Ollie Farnsworth
Register Mesne Conveyance Greenville County, S. C.

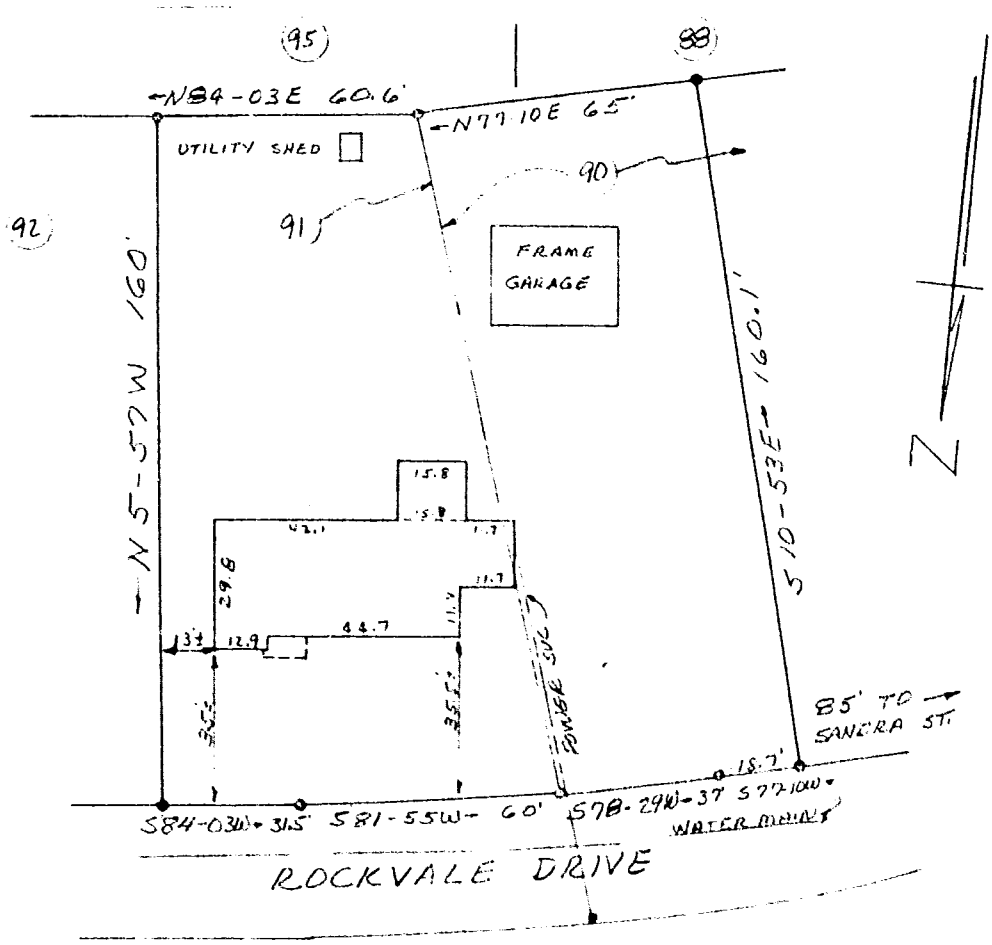

PROPERTY OF
CLYDE RAYMOND TAYLOR
NEAR GREENVILLE, S.C.
OCT 10, 1968 SCALE 1"=40'

This is to certify that on Oct. 10, 1968 I surveyed the property shown on this plat, known as Lot No. 91 and the greater portion of Lot No. 90 of Section One of Rockvale, plat filed in R&C Office for Greenville Co. in Plat Book qq at page 103, and that the property lines, walls and building are as shown hereon, and that the buildings located on said lot do not project nor encroach on adjacent streets or property, and that no adjacent walls or buildings project nor encroach on said lot, and that no utility lines cross this lot except as shown hereon.

Surveyed by Campbell & Clarkson

H. C. Clarkson Jr.
S.C.R.L.S. No. 2589

9152

ZZZ-13