Plat Book-ZZZ-Page 151

#15285 Filed This 24 day of Dec 19 68

And Recorded in Vol. ZZZ Page 151 at 2:49 P.

Ollie Farnsworth

Register Mesne Conveyance Greenville County, S. C.

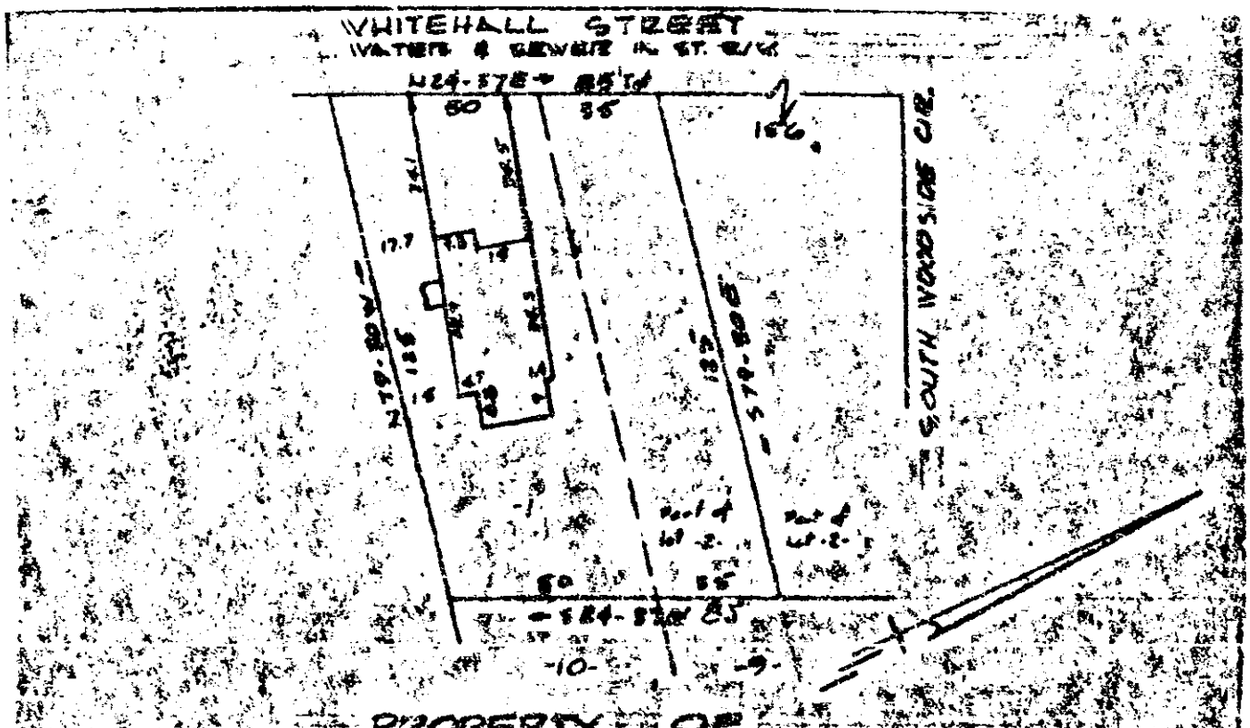


PROPERTY OF

CHARLES D. BELUE & LINDA R. BELUE

GREENVILLE S.C.

SCALE 1"=40' 16 DEC 68

This is to certify that on the 16th Day of December 1968 I surveyed the property shown on this plat being known as Lot 1 and Part of Lot 2 on a plat of the Property of LILLIE J. BUTLER and recorded in the RMC Office Greenville County, S.C., in Plat Book "H" at Page 33; and that the property lines, walls and buildings are as shown hereon, and that the walls and buildings located on said lot do not encroach or project on adjacent street or property, and that no adjacent walls or buildings encroach or project on said premises, and no power lines cross this property except as shown hereon.

R. B. Bruce

R.B. BRUCE RLS #1[illegible]

ZZZ-151

CAROLINA ENGINEERING AND SURVEYING COMPANY
Greenville, South Carolina

15285

FILED
GREENVILLE CO. S.C.
DEC 24 2 49 PM 1968
OLLIE FARNSWORTH
R.M.C.

50¢

38/72